IREDELL COUNTY HEALTH DEPARTMENT

STATESVILLE 704-878-5305 MOORESVILLE 704-664-5281

IMPROVEMENT PERMIT / AUTHORIZATION TO CONSTRUCT / OPERATION PERMIT / EXISTING SYSTEM INSPECTION

4760-96-5356.30 4760-85-9783

PERMIT# 112317 PIN# DATE Nov. 3, 03

OWNER OR CONTRACTOR Overcash Land & Development / Tammy Tabor, Jan PHONE: Business Home

ADDRESS P.O. Box 3846, Mooresville, N.C.

LOCATION I15-21 N. TR Shinnville RD. X CREEK ~1/4 mile TL. Sonoma TR Nuthatch Dr. 2nd lot on left

SUBDIVISION Shinnville Estates BLOCK / SECTION II LOT 30 LOT AREA .661 Ac SITE CLASS. PS DESIGN FLOW 360 gpd L.T.A.R. .25-.3

Septic Tank: 1000 Gallons; STB 1012 Date 10/1/03

Pump Tank: 1000 Gallons; PT 17 Date 10/24/03

Pump Make: Goulds Model WE0311M Serial No.

Nitrification Field: No Fields 1 Square Feet 1080 Linear Feet 360

No Lines 4@90' Trench Width 36" Max Trench Bottom Depth 36" Gravel Depth NA

☑ New System ☐ Repair System Type: I, II, III, IV, V, VI

System Description: PM - 25% Reduction

Repair System Description: LP 25-50% Reduction

Maintenance Agreement Required: ☐ Yes ☑ No initially

☑ House/Mod. Home No. Bedrooms 3

☐ Mobile Home No. Bathrooms 2

☐ Business No. Employees

☐ Other

☐ Slab ☑ Crawl Space ☐ Basement w/plumbing ☐ Basement wo/plumbing


Water Supply: ☑ Individual ☐ Public ☐ Community

Comments:/Conditions:

Comments:/Conditions:

1"=50'

INITIAL SITE SKETCH

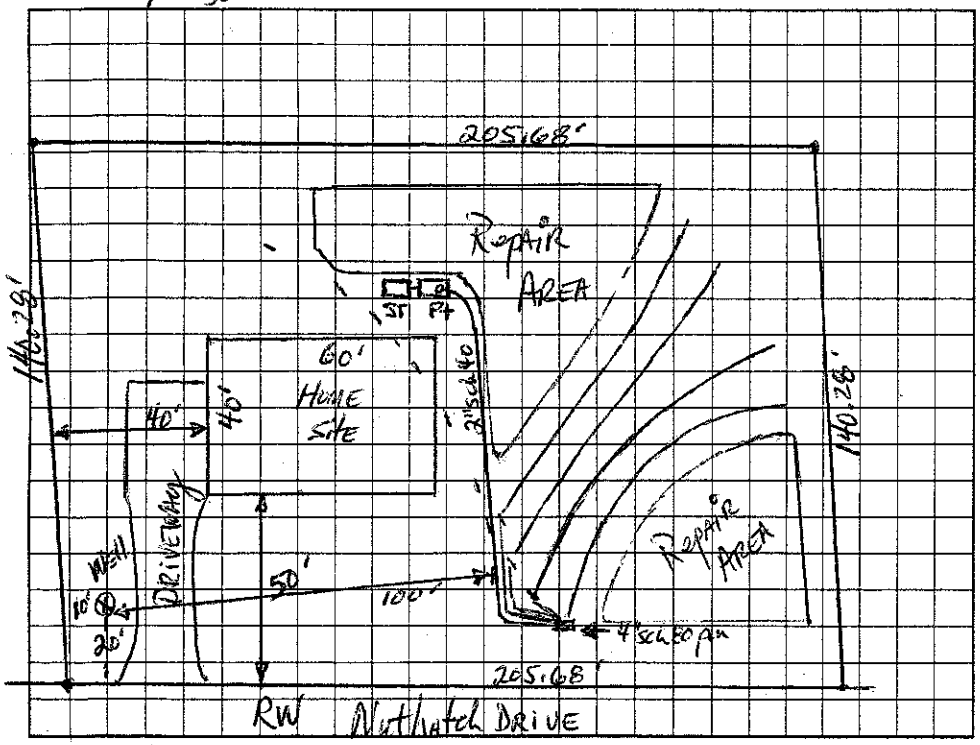

AS BUILT SKETCH

Permit can be suspended or revoked if any false information is supplied toward securing the permit/any unauthorized changes are made to the site/any unauthorized changes are made in the installation of the system. Improvement Permit with plat valid without expiration. Improvement Permit with site plan valid for sixty months. Authorization to Construct is valid for a period equal to that of Improvement Permit – not to exceed sixty months.

Signed: date

Improvement Permit by: date 11-3-03

Authorization to Construct by: date 3/30/04

Installed by: 4-1 Backhoe

Operation Permit by: LS date 4/20/04

Existing System Inspection by: date

HEALTH DEPT. COPY: WHITE OWNER COPY (FINAL): YELLOW OWNER COPY (INITIAL): PINK