IREDELL COUNTY HEALTH DEPARTMENT

STATESVILLE 704-878-5305 MOORESVILLE 704-664-5281

IMPROVEMENT PERMIT / AUTHORIZATION TO CONSTRUCT / OPERATION PERMIT / EXISTING SYSTEM INSPECTION

PERMIT# 11090 2 PIN# ~~4760-91-0975~~ 4760911708 DATE 2/7/03

OWNER OR CONTRACTOR Patrick Grogan PHONE: Business _____ Home 704-663-0755

ADDRESS 105 Restful Ln. Mooresville NC 28117

LOCATION 115N, TR Shinnville, on Rt before Perry Park Ln 1086 Shinnville Rd

SUBDIVISION _____ BLOCK / SECTION _____ LOT _____ LOT AREA 15 AC SITE CLASS. PS DESIGN FLOW 360 L.T.A.R. 0.5

Septic Tank: 1000 Gallons; STB 794 Date 6/9/04
Pump Tank: _____ Gallons; PT _____ Date _____
Pump Make: _____ Model _____ Serial No. _____
Nitrification Field: No Fields 1 Square Feet 1200 Linear Feet 400
No Lines 4@100' Trench Width 36" Max Trench Bottom Depth 36" Gravel Depth 12"

☒ New System ☐ Repair System Type: I, II, III, IV, V, VI
System Description: Gravity Conventional/Some
Repair System Description: _____
Maintenance Agreement Required: ☐ Yes ☒ No


☒ House/Mod. Home No. Bedrooms 3
☐ Mobile Home No. Bathrooms 3
☐ Business No. Employees _____
☐ Other _____
☐ Slab ☐ Crawl Space ☒ Basement w/plumbing ☐ Basement wo/plumbing

Water Supply: ☒ Individual ☐ Public ☐ Community


Comments/Conditions:

Comments/Conditions:

INITIAL SITE SKETCH

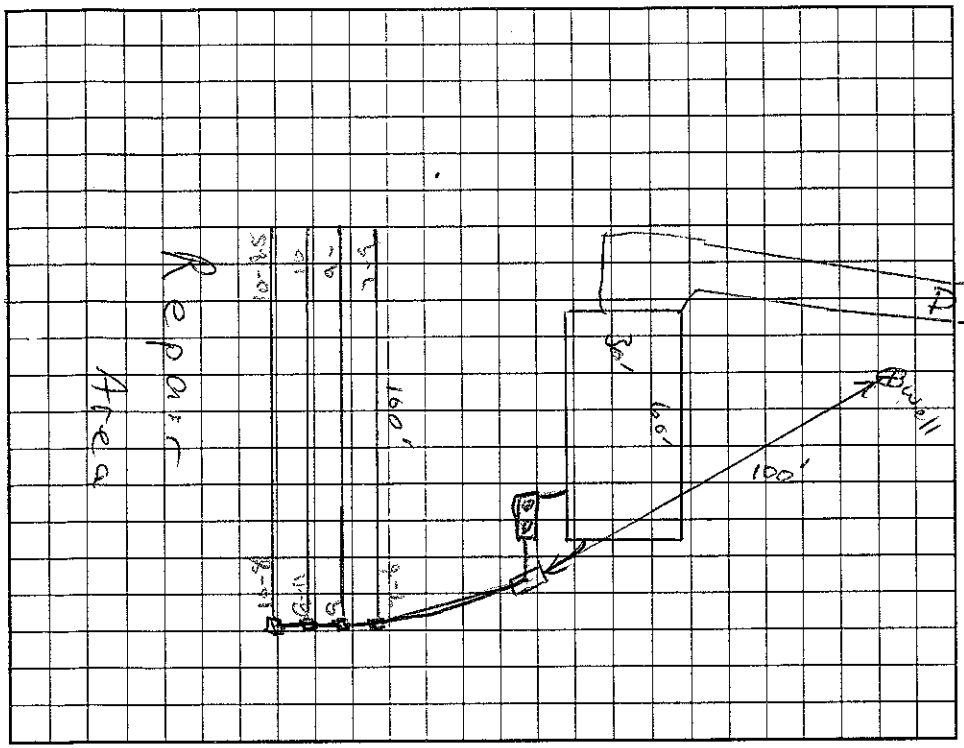

AS BUILT SKETCH

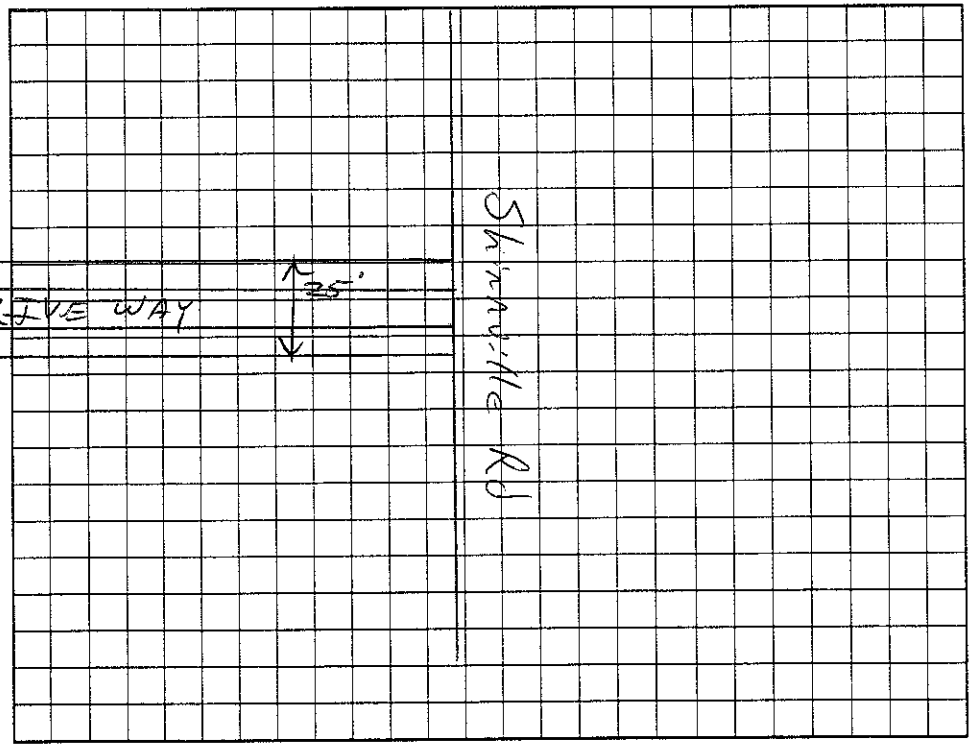

Permit can be suspended or revoked if any false information is supplied toward securing the permit/any unauthorized changes are made to the site/any unauthorized changes are made in the installation of the system. Improvement Permit with plat valid without expiration. Improvement Permit with site plan valid for sixty months. Authorization to Construct is valid for a period equal to that of Improvement Permit – not to exceed sixty months.

Signed: Patrick Grogan date 2/7/03 Installed by: Osborn

Improvement Permit by: _____ RS date 2/7/03 Operation Permit by: Wesley Sparks RS. date 7/14/04

Authorization to Construct by: _____ RS date 2/7/03 Existing System Inspection by: _____ date _____

HEALTH DEPT. COPY: WHITE OWNER COPY (FINAL): YELLOW OWNER COPY (INITIAL): PINK