IREDELL COUNTY HEALTH DEPARTMENT

STATESVILLE 704-878-5305 MOORESVILLE 704-664-5281

IMPROVEMENT PERMIT / AUTHORIZATION TO CONSTRUCT / OPERATION PERMIT / EXISTING SYSTEM INSPECTION

PERMIT# 077670 PIN# 4760 ~~93-2374~~ 92-6964 DATE 11/23/98

OWNER OR CONTRACTOR Nancy Grubbs PHONE: Business Home 664-7855

ADDRESS 1101 Shinnville Rd. Cleveland, NC. 27014

LOCATION 115-21 N TR Shinnville Rd., ~ 3 miles on (R) just past Brawley Rd.

SUBDIVISION Cedar Grove BLOCK / SECTION LOT 2 LOT AREA .47AC SITE CLASS. PS DESIGN FLOW 240 L.T.A.R. .3

Septic Tank: 1000 Gallons; STB 825 Date 11/15/98
Pump Tank: Gallons; PT Date
Pump Make: Model Serial No.
Nitrification Field: No Fields 1 Square Feet 630+ Linear Feet 210*
No Lines 3 Trench Width 36" Max Trench Bottom Depth 36" Gravel Depth SAND.

☑ New System ☐ Repair System Type: I, II, III, IV, V, VI
System Description: Gravity Lpt Plastic
Repair System Description:
Maintenance Agreement Required: ☐ Yes ☒ No

☐ House/Mod. Home ☒ Mobile Home ☐ Business ☐ Other
No. Bedrooms 2 No. Bathrooms 2 No. Employees


☐ Slab ☒ Crawl Space ☐ Basement w/plumbing ☐ Basement wo/plumbing

Water Supply: ☒ Individual ☐ Public ☐ Community

Comments:/Conditions:

Comments:/Conditions:

INITIAL SITE SKETCH

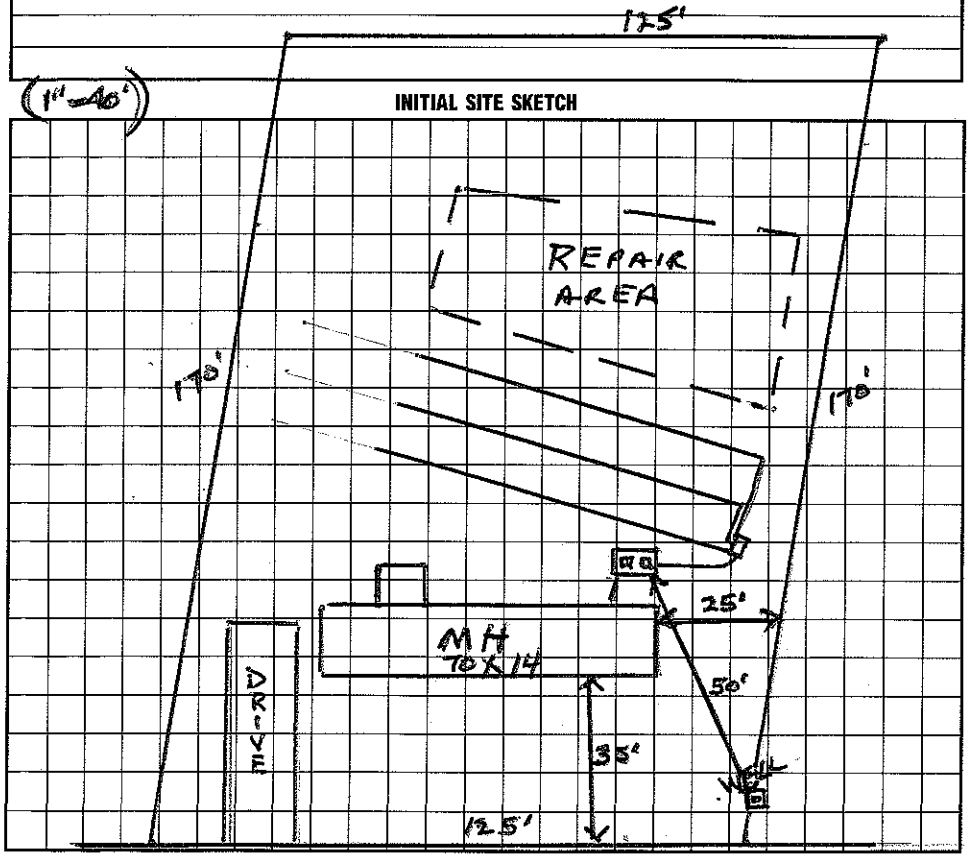

AS BUILT SKETCH

I understand that this permit can be suspended or revoked if any false information is supplied toward securing the permit/any unauthorized changes are made to the site/any unauthorized changes are made in the installation of the system. Improvement Permit with plat valid without expiration. Improvement Permit with site plan valid for sixty months. Authorization to Construct is valid for a period equal to that of Improvement Permit – not to exceed sixty months.

Signed: William A Grubbs SHINNVILLE RD. date 11-24-98 Installed by: Richard Foster

Improvement Permit by: Wesley Sparks RS. date 11/23/98 Operation Permit by: Wesley Sparks RS. date 12/4/98

Authorization to Construct by: Wesley Sparks RS. date 11/23/98 Existing System Inspection by: date

HEALTH DEPT. COPY: WHITE INSPECTION COPY (FINAL): GREEN OWNER COPY (FINAL): YELLOW INSPECTION COPY (INITIAL): PINK OWNER COPY (INITIAL): GOLD