IREDELL COUNTY HEALTH DEPARTMENT

STATESVILLE 704-878-5305 MOORESVILLE 704-664-5281

IMPROVEMENT PERMIT / AUTHORIZATION TO CONSTRUCT / OPERATION PERMIT / EXISTING SYSTEM INSPECTION

PERMIT# 122116 PIN# ~~4760-92-4460.1~~ 4760923169 DATE 7/16/04

OWNER OR CONTRACTOR Fleetwood Homes PHONE: Business (704) 822-4641 Home

ADDRESS 1220 N. Side Drive Statesville, N.C. 28625

LOCATION Hwy 21, (R) Shinnville Rd, go past Perry Park Lane, on Right before 11/8 Shinnville Rd (~500 ft off road)

SUBDIVISION BLOCK / SECTION LOT 1 LOT AREA 2.13 Ac SITE CLASS. F.5 DESIGN FLOW 360 L.T.A.R. .30

Septic Tank: 1000 Gallons; STB 760 Date 4-4-04
Pump Tank: Gallons; PT Date
Pump Make: Model Serial No.
Nitrification Field: No Fields 1 Square Feet 1200 Linear Feet 400
No Lines 7 Trench Width 36 Max Trench Bottom Depth 30 Gravel Depth 12"

☒ New System ☐ Repair System Type: I (II) III, IV, V, VI
System Description: Gravity, Conventional
Repair System Description: Gravity 25% Reduction
Maintenance Agreement Required: ☐ Yes ☒ No


☐ House/Mod. Home No. Bedrooms 3
☒ Mobile Home No. Bathrooms 2
☐ Business No. Employees
☐ Other
☐ Slab ☒ Crawl Space ☐ Basement w/plumbing ☐ Basement wo/plumbing

Water Supply: ☒ Individual ☐ Public ☐ Community


Comments/Conditions: (1) Install one Flow divider tee + 6 drop boxes on contour (2) Maintain correct setbacks (3) Keep well 100ft from septic system

Comments/Conditions: ~~☆~~ Well not installed yet at time of inspection.

INITIAL SITE SKETCH

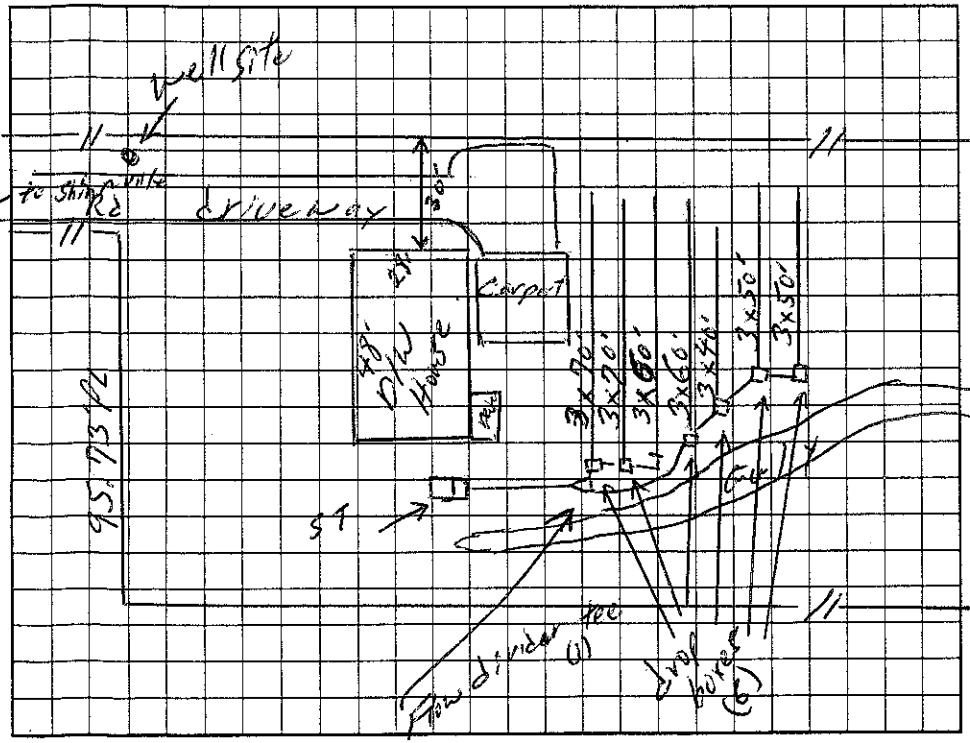

AS BUILT SKETCH

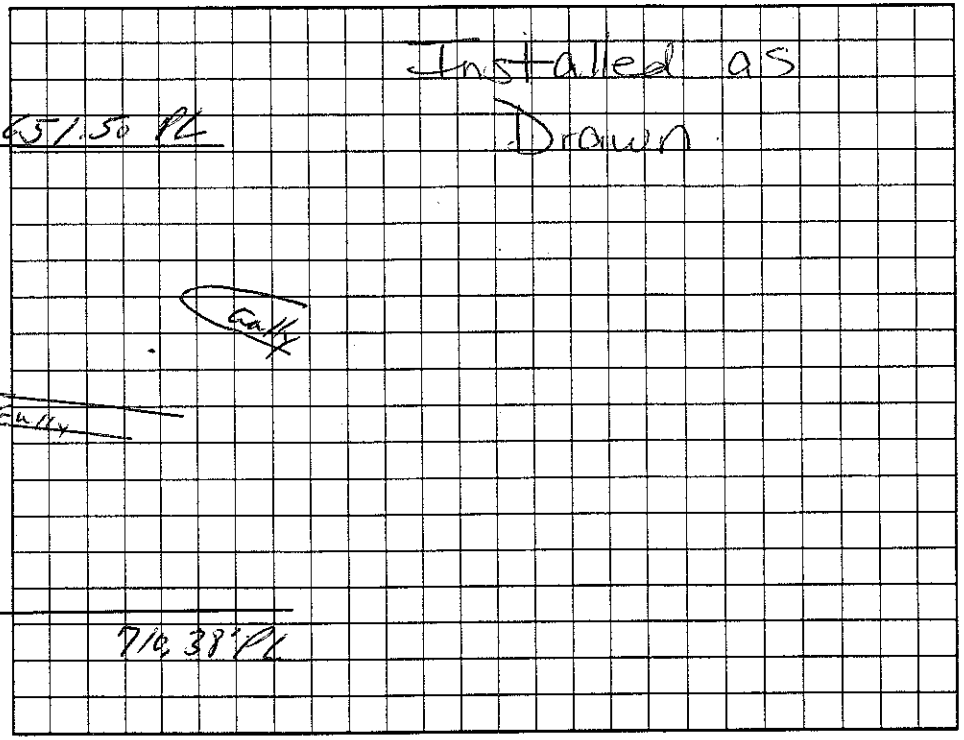

Permit can be suspended or revoked if any false information is supplied toward securing the permit/any unauthorized changes are made to the site/any unauthorized changes are made in the installation of the system. Improvement Permit with plat valid without expiration. Improvement Permit with site plan valid for sixty months. Authorization to Construct is valid for a period equal to that of Improvement Permit – not to exceed sixty months.

Signed: date 7/15/04 Installed by: Abee's Grading R.S.

Improvement Permit by: William A Johnson date 7/16/04 Operation Permit by: Marvin H Dalton date 7/21/04

Authorization to Construct by: William A Johnson date 7/16/04 Existing System Inspection by: date

HEALTH DEPT. COPY: WHITE OWNER COPY (FINAL): YELLOW OWNER COPY (INITIAL): PINK