IREDELL COUNTY HEALTH DEPARTMENT

STATESVILLE 704-878-5305 MOORESVILLE 704-664-5281

IMPROVEMENT PERMIT / AUTHORIZATION TO CONSTRUCT / OPERATION PERMIT / EXISTING SYSTEM INSPECTION

PERMIT# 071934 PIN# 4760 94 0772

OWNER OR CONTRACTOR Donald S Little PHONE: Business DATE 3/2/97

ADDRESS 1201 Shinnville Rd. Cleveland, NC 27013 Home 528-3996

LOCATION 115-21N, ~5miles x bridge to first drive on (L), follow drive to house sit on (L)

SUBDIVISION N/A BLOCK / SECTION LOT LOT AREA ~1.4ac SITE CLASS. RS DESIGN FLOW 360 L.T.A.R. .225

Septic Tank: 1000 Gallons; STB 794 Date 5/12/98
Pump Tank: Gallons; PT Date
Pump Make: Model Serial No.
Nitrification Field; No Fields 1 Square Feet 1600 Linear Feet 533
No Lines 4 Trench Width 36" Max Trench Bottom Depth 24"

☒ New System ☐ Repair System Type: I, (II), III, IV, V, VI
System Description: GRAVITY - TYPE II
Repair System Description: SAME
Maintenance Agreement Required: ☐ Yes ☒ No
Gravel Depth 12"


☒ House/Mod. Home No. Bedrooms 3
☐ Mobile Home No. Bathrooms 2
☐ Business No. Employees
☐ Other
☐ Slab ☒ Crawl Space ☐ Basement w/plumbing ☐ Basement wo/plumbing

Water Supply: ☒ Individual ☐ Public ☐ Community FROM NH SITE

Comments:/Conditions:

1" = 50'

INITIAL SITE SKETCH

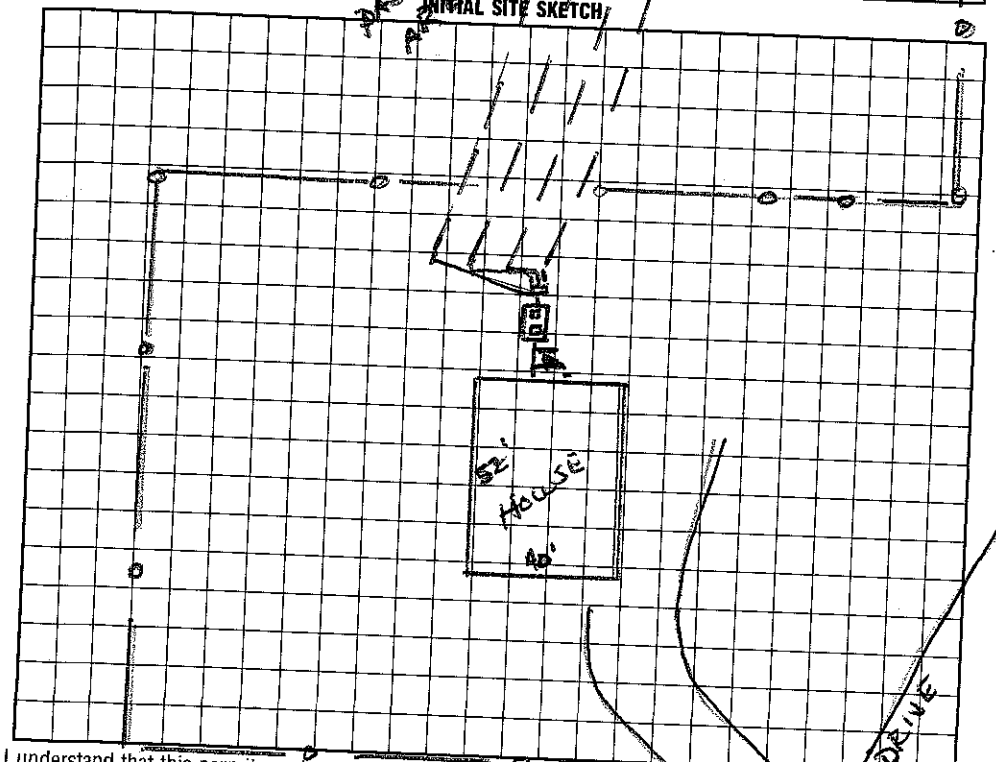

Comments:/Conditions:

AS BUILT SKETCH

The proposed / existing BUILDING addition does not appear to impact the existing septic system.
**NOTE:

Date: 12-4-09 REHS
ICHD-Environmental Health Division

SEE ATTACHED DRAWING

I understand that this permit can be suspended or revoked if any false information is supplied toward securing the permit/any unauthorized changes are made to the site/any unauthorized changes are made in the installation of the system. Improvement Permit with plat valid without expiration. Improvement Permit with site plan valid for sixty months. Authorization to Construct is valid for a period equal to that of Improvement Permit – not to exceed sixty months.

Signed: *

Improvement Permit by: Wesley Sparks RS. date 3/5/98

Authorization to Construct by: Wesley Sparks RS date 3/2/98

Installed by: James Hudson

Operation Permit by: Wesley Sparks RS date 7/31/98

Existing System Inspection by: Wesley Sparks RS date 7/31/98

HEALTH DEPT. COPY: WHITE INSPECTION COPY (FINAL): GREEN OWNER COPY (FINAL): YELLOW INSPECTION COPY (INITIAL): PINK OWNER COPY (INITIAL): GOLD