IREDELL COUNTY HEALTH DEPARTMENT

STATESVILLE 704-878-5305 (2.00) MOORESVILLE 704-664-5281

IMPROVEMENT PERMIT / AUTHORIZATION TO CONSTRUCT / OPERATION PERMIT / EXISTING SYSTEM INSPECTION

PERMIT# 86597 PIN# 4760966477 PT 4760951241

OWNER OR CONTRACTOR OVERCASH LAND & DEV. DATE 3/15/00

ADDRESS PO BOX 3846 MOORESVILLE NC 28117 PHONE: Business 528-3527 Home

LOCATION 115 N- TR SHINVILLE - TL SONOMA DRIVE - 5TH ON LT.

SUBDIVISION SHINVILLE EST BLOCK / SECTION I LOT 5 LOT AREA .91AC SITE CLASS. B DESIGN FLOW 360 GPD L.T.A.R. .36AR/FT

Septic Tank: 1000 Gallons; STB 312 Date 4/12/00

Pump Tank: Gallons; PT Date

Pump Make: Model Serial No.

Nitrification Field: No Fields 1 Square Feet 1200 Linear Feet 400

No Lines 5@80' Trench Width 36" Max Trench Bottom Depth 36" Gravel Depth 12"

☑ New System ☐ Repair System Type: I (II) III, IV, V, VI

System Description: GRAVITY CONVENTIONAL

Repair System Description: SAME

Maintenance Agreement Required: ☐ Yes ☑ No

☐ House/Mod. Home No. Bedrooms 3

☑ Mobile Home No. Bathrooms 2

☐ Business No. Employees

☐ Other


☐ Slab ☑ Crawl Space ☐ Basement w/plumbing ☐ Basement wo/plumbing

Water Supply: ☑ Individual ☐ Public ☐ Community

Comments:/Conditions:

Comments:/Conditions: KEEP WELL 100' FROM ANY SEPTIC SYSTEM.

INITIAL SITE SKETCH 1"=50'

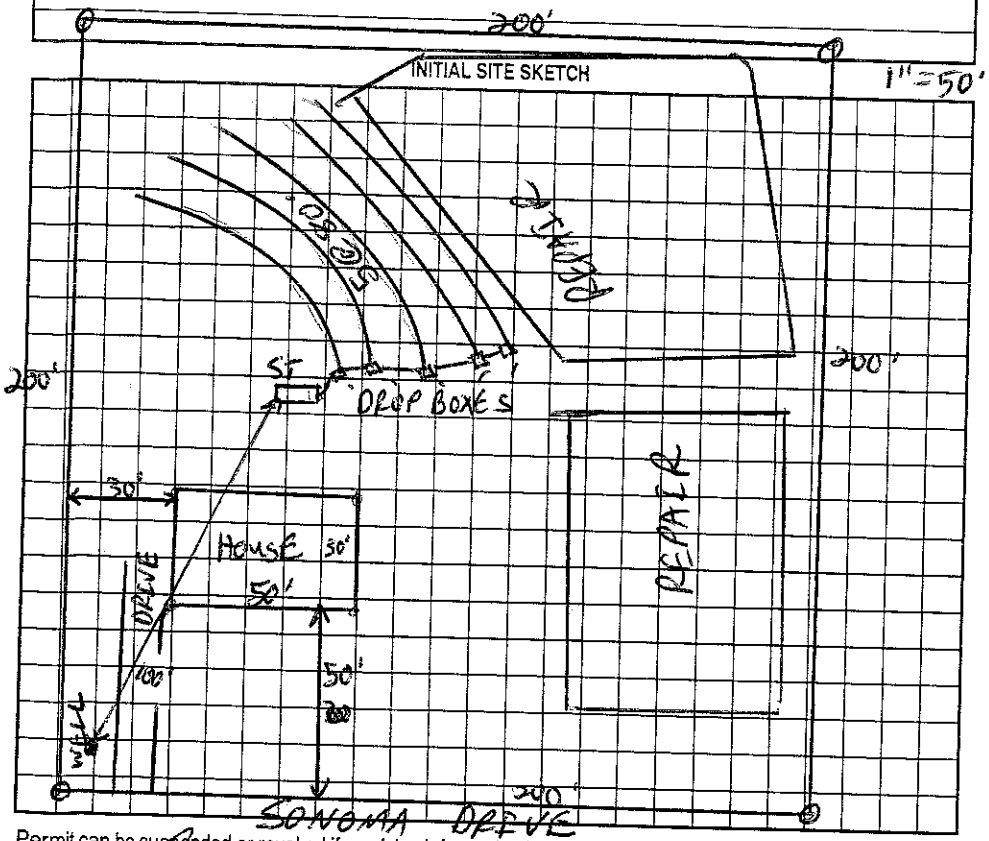

AS BUILT SKETCH

Permit can be suspended or revoked if any false information is supplied toward securing the permit/any unauthorized changes are made to the site/any unauthorized changes are made in the installation of the system. Improvement Permit with plat valid without expiration. Improvement Permit with site plan valid for sixty months. Authorization to Construct is valid for a period equal to that of Improvement Permit – not to exceed sixty months.

Signed: date

Improvement Permit by: RS date 3/15/00

Authorization to Construct by: date 4/4/00

Installed by: BUDDY CHANEY

Operation Permit by: RS date 5/18/00

Existing System Inspection by: date

HEALTH DEPT. COPY: WHITE OWNER COPY (FINAL): YELLOW OWNER COPY (INITIAL): PINK