IREDELL COUNTY HEALTH DEPARTMENT


ENVIRONMENTAL HEALTH DIVISION

PAGE 2: *SITE PLAN WORKSHEET*

SEE THE "SAMPLE SITE PLAN" BELOW. *INCOMPLETE SITE PLANS WILL BE RETURNED TO YOU FOR COMPLETION AND MAY RESULT IN A DELAY IN THE ISSUANCE OF YOUR SEPTIC SYSTEM PERMIT!!!*

Place an (X) beside each item as you complete the site plan:

( ) Property Line measurements are clearly identified
( ) All proposed structures are indicated
( ) Front and side setbacks from property line
( ) Preferred driveway location and well location
( ) Area you prefer your septic system to be placed
( ) North arrow, or other sufficient indicator of direction

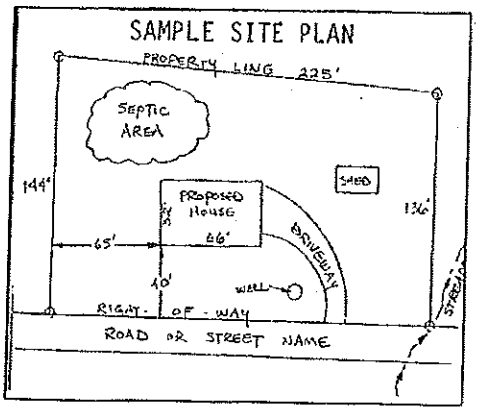


Circle N/A on the following if appropriate:

Location of septic systems and wells within 100' of your property	N/A
Location of easements and rights of ways on your property	N/A
Location of any designated wetlands on the property	N/A

USE THIS SPACE TO DRAW YOUR SITE PLAN

Show: proposed house or business footprint, wells, water lines, patios, pools and decks, and any other item that will occupy space on the site

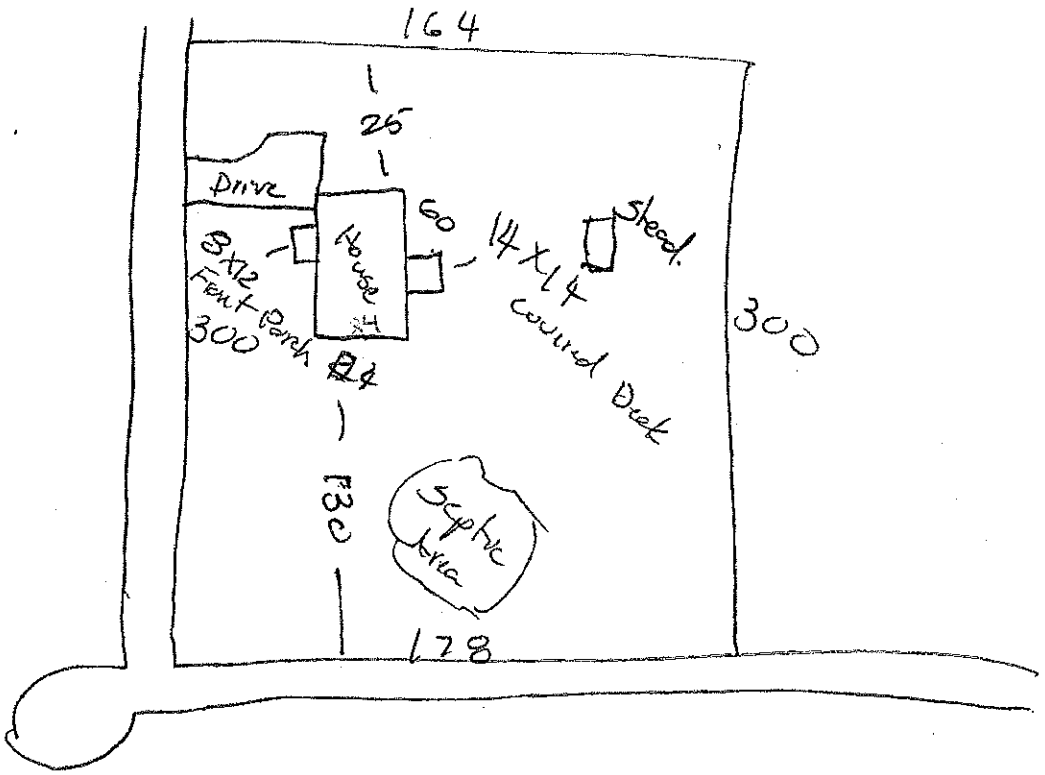

Signature: _____

Property owner or owner's legal representative signature (SIGNATURE REQUIRED)

4/17/15

DATE

4:00

IREDELL COUNTY HEALTH DEPARTMENT

STATESVILLE 704-878-5305 MOORESVILLE 704-664-52

IMPROVEMENT PERMIT / AUTHORIZATION TO CONSTRUCT / OPERATION PERMIT / EXISTING SYSTEM IN

PERMIT# 86599 PIN# 4760966477 ff 4760951501 DATE 3/16/00

OWNER OR CONTRACTOR OVERCASH LAND & DEV./OAKWOOD HOMES PHONE: Business 528-3846 Home

ADDRESS PO Box 3846 MOORESVILLE NC 28117

LOCATION 115 N- TR SHINNVILLE RD - TL SONOMA DRIVE - ON RT - CORNER ON NUTHATCH DRIVE

SUBDIVISION SHINNVILLE EST. BLOCK / SECTION I LOT 10 LOT AREA 1.09 AC. SITE CLASS. PS DESIGN FLOW 300GPD L.T.A.R. .3 gal/sq ft

Septic Tank: 1000 Gallons; STB 1012 Date 2/17/00

Pump Tank Gallons; PT Date

Pump Make: Model Serial No.

Nitrification Field: No Fields 1 Square Feet 1200 Linear Feet 400

No Lines 4@100' Trench Width 36" Max Trench Bottom Depth 36" Gravel Depth 12"

☑ New System ☐ Repair System Type: I II III IV V VI

System Description: GRAVITY CONVENTIONAL

Repair System Description: SAME

Maintenance Agreement Required: ☐ Yes ☑ No

☐ House/Mod. Home No. Bedrooms 3

☑ Mobile Home No. Bathrooms 3

☐ Business No. Employees

☐ Other


☐ Slab ☑ Crawl Space ☐ Basement w/plumbing ☐ Basement wo/plumbing

Water Supply: ☑ Individual ☐ Public ☐ Community


Comments/Conditions: * KEEP WELL 100' FROM ANY SEPTIC SYSTEM *

Comments/Conditions:

INITIAL SITE SKETCH 1"=50'

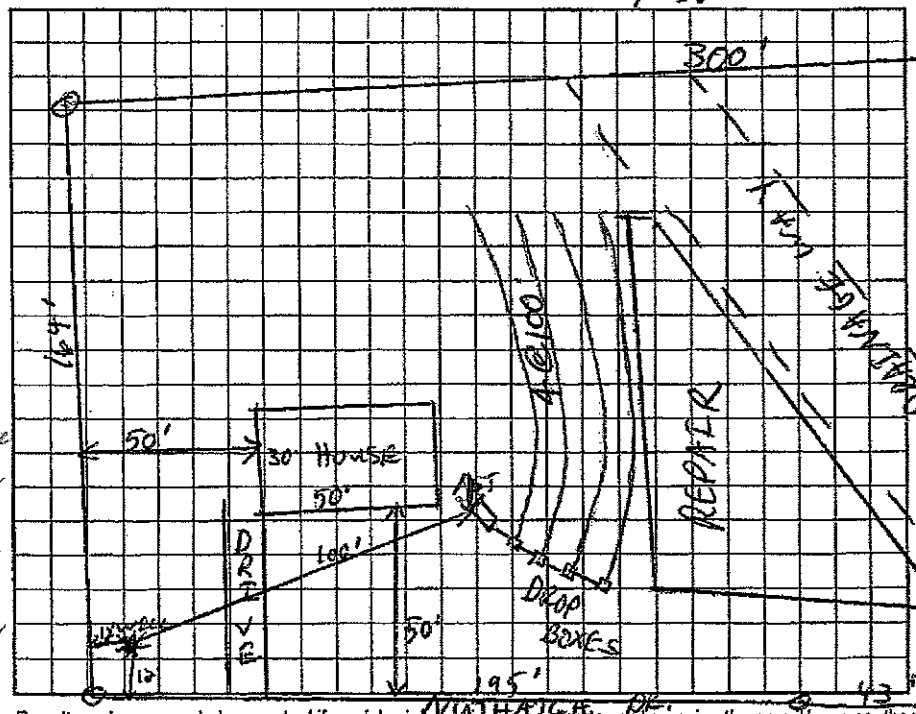

AS BUILT SKETCH

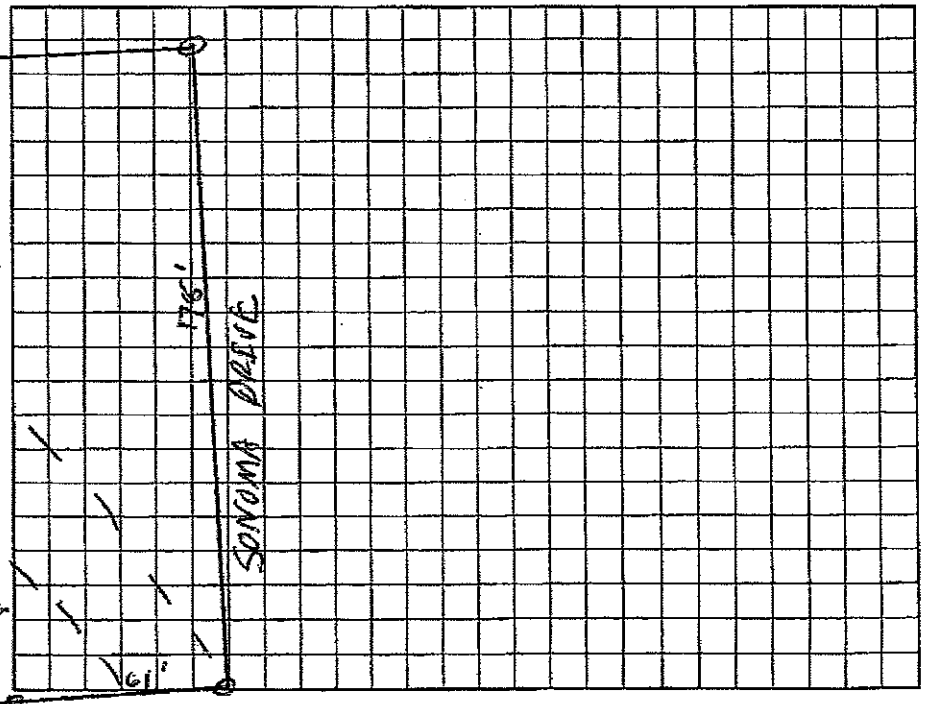

ST off bank from house 8' off side & 36 from house to line

Permit can be suspended or revoked if any false information is supplied toward securing the permit/any unauthorized changes are made to the site/any unauthorized changes are made in the installation of the system. Improvement Permit with plat valid without expiration. Improvement Permit with site plan valid for sixty months. Authorization to Construct is valid for a period equal to that of Improvement Permit – not to exceed sixty months.

Signed: Roger Overcash date

Improvement Permit by: [signature] RS date 3/16/00

Authorization to Construct by: [signature] RS date 7/3/02

Installed by: Craig Thompson

Operation Permit by: [signature] RS date 7/17/02

Existing System Inspection by: date

HEALTH DEPT. COPY: WHITE OWNER COPY (FINAL): YELLOW OWNER COPY (INITIAL): PINK

midway 33' off house to 1st line