IREDELL COUNTY HEALTH DEPARTMENT

STATESVILLE 704-878-5305 MOORESVILLE 704-664-5281

IMPROVEMENT PERMIT / AUTHORIZATION TO CONSTRUCT / OPERATION PERMIT / EXISTING SYSTEM INSPECTION

PERMIT# 88305 PIN# ~~4760966477 PT~~ 4760953149 DATE 3/15/00

OWNER OR CONTRACTOR OVERCASH LAND & DEV // David & Deborah Nichols PHONE: Business 528-2529 Home

ADDRESS PO Box 3546 MOORESVILLE NC 28117

LOCATION 115N - TR SHINVILLE RD - TL SONOMA DRIVE - 4TH ON LT

SUBDIVISION SHINVILLE EST. BLOCK / SECTION I LOT 4 LOT AREA .91AC SITE CLASS. PS DESIGN FLOW 360 L.T.A.R. .3 gal/ft²

Septic Tank: 1000 Gallons; STB 1012 Date 5/3/02
Pump Tank: Gallons; PT Date
Pump Make: Model Serial No.
Nitrification Field: No Fields 1 Square Feet 1200 Linear Feet 400
No Lines 3@134' Trench Width 36" Max Trench Bottom Depth 36" Gravel Depth 12"

☑ New System ☐ Repair System Type: I II III IV V VI
System Description: GRAVITY CONVENTIONAL
Repair System Description: SAME
Maintenance Agreement Required: ☐ Yes ☑ No

☐ House/Mod. Home ☑ Mobile Home ☐ Business ☐ Other
No. Bedrooms 3 No. Bathrooms 2 No. Employees


☐ Slab ☑ Crawl Space ☐ Basement w/plumbing ☐ Basement wo/plumbing

Water Supply: ☑ Individual ☐ Public ☐ Community

Comments:/Conditions:

Comments:/Conditions: ~~1~~ KEEP WELL ~~50~~ 100' FROM ANY SEPTIC SYSTEM. ~~1~~

INITIAL SITE SKETCH

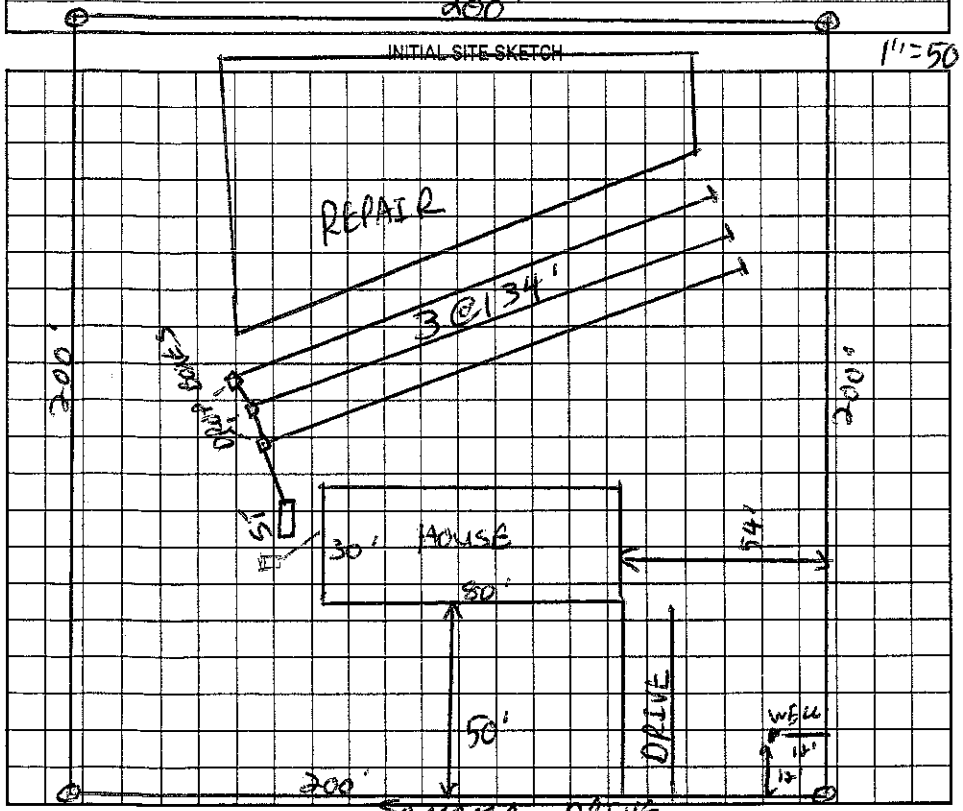

AS BUILT SKETCH

Permit can be suspended or revoked if any false information is supplied toward securing the permit/any unauthorized changes are made to the site/any unauthorized changes are made in the installation of the system. Improvement Permit with plat valid without expiration. Improvement Permit with site plan valid for sixty months. Authorization to Construct is valid for a period equal to that of Improvement Permit – not to exceed sixty months.

Signed: date

Improvement Permit by: PS date 3/15/00

Authorization to Construct by: date 8-12-02

Installed by: A-1 Backhoe

Operation Permit by: PS date 5/14/02

Existing System Inspection by: date

HEALTH DEPT. COPY: WHITE OWNER COPY (FINAL): YELLOW OWNER COPY (INITIAL): PINK