IREDELL COUNTY HEALTH DEPARTMENT

STATESVILLE 704-878-5305 MOORESVILLE 704-664-5281

IMPROVEMENT PERMIT / AUTHORIZATION TO CONSTRUCT / OPERATION PERMIT / EXISTING SYSTEM INSPECTION

PERMIT# 86596 PIN# ~~4760966477~~ PI 4760955168 DATE 3/16/00

OWNER OR CONTRACTOR OVERCASH LAND + DEV/ DEE A. OVERCASH PHONE: Business 528-2529 Home

ADDRESS PO BOX 3846 MOORESVILLE NC 28117

LOCATION 115N - TR SHINVILLE - TL SONOMA - 3rd ON LT

SUBDIVISION SHINVILLE EST. BLOCK / SECTION I LOT 3 LOT AREA 1.03AC SITE CLASS. PS DESIGN FLOW 360 GPD L.T.A.R. .360D/Fp2

Septic Tank: 1000 Gallons; STB 99-NC Date 3/22/00

Pump Tank: Gallons; PT Date

Pump Make: Model Serial No.

Nitrification Field: No Fields 1 Square Feet 1200 Linear Feet 400

No Lines 4@100' Trench Width 36" Max Trench Bottom Depth 36" Gravel Depth 12"

☑ New System ☐ Repair System Type: I, II, III, IV, V, VI

System Description: GRAVITY CONVENTIONAL

Repair System Description: SAME

Maintenance Agreement Required: ☐ Yes ☑ No

☐ House/Mod. Home No. Bedrooms 3

☑ Mobile Home No. Bathrooms 2

☐ Business No. Employees

☐ Other


☐ Slab ☑ Crawl Space ☐ Basement w/plumbing ☐ Basement wo/plumbing

Water Supply: ☑ Individual ☐ Public ☐ Community

Comments:/Conditions: *KEEP WELL 100' FROM ANY SEPTIC SYSTEM.*

1"=50'

INITIAL SITE SKETCH

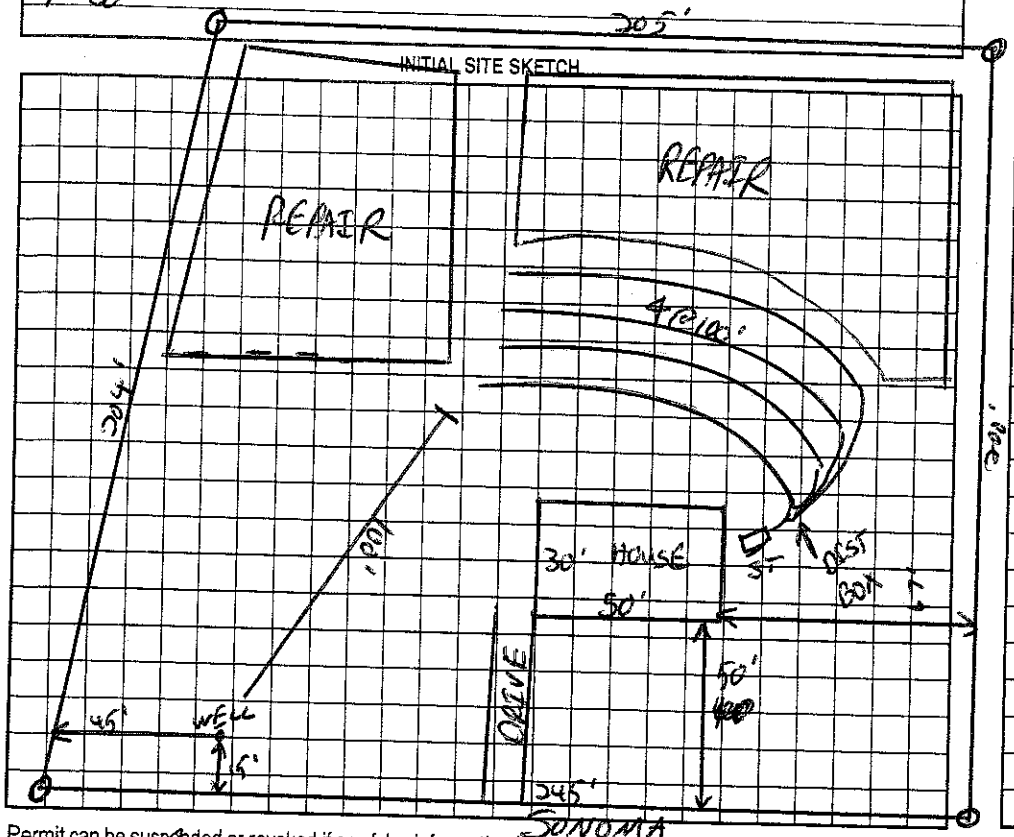

Comments:/Conditions:

AS BUILT SKETCH

Permit can be suspended or revoked if any false information is supplied toward securing the permit/any unauthorized changes are made to the site/any unauthorized changes are made in the installation of the system. Improvement Permit with plat valid without expiration. Improvement Permit with site plan valid for sixty months. Authorization to Construct is valid for a period equal to that of Improvement Permit – not to exceed sixty months.

Signed: date

Improvement Permit by: C. RS date 3/16/00

Authorization to Construct by: RS date 5-5-00

Installed by: WT Norwood

Operation Permit by: Wesley Sparks RS. date 6/20/00

Existing System Inspection by: date

HEALTH DEPT. COPY: WHITE OWNER COPY (FINAL): YELLOW OWNER COPY (INITIAL): PINK