IREDELL COUNTY HEALTH DEPARTMENT

STATESVILLE 704-878-5305 50.00 Paid MOORESVILLE 704-664-5281

IMPROVEMENT PERMIT / AUTHORIZATION TO CONSTRUCT / OPERATION PERMIT / EXISTING SYSTEM INSPECTION

PERMIT# 088307 PIN# 4760 966477 PT 4760957495 DATE 1/17/02

OWNER OR CONTRACTOR Oakwood Homes PHONE: Business 704 528-4516 Home

ADDRESS 1042 Charlotte Hwy Troutman NC 28166

LOCATION 115 N TR Shinnville TL Sonoma on corner w/ Electra

SUBDIVISION Shinnville Est. BLOCK / SECTION LOT 14 LOT AREA 1.09 AC SITE CLASS. PS DESIGN FLOW 480 L.T.A.R. 0.25

Septic Tank: 1000 Gallons; STB 312 Date 6/22/01

Pump Tank: Gallons; PT Date

Pump Make: Model 2061 Serial No.

Nitrification Field No Fields 1 Square Feet 1920 Linear Feet 685

No Lines 5 @ 137 Trench Width 36" Max Trench Bottom Depth 36" Gravel Depth 12"

☒ New System ☐ Repair System Type: I (II) III IV V VI

System Description: Gravity Conventional

Repair System Description: Stone

Maintenance Agreement Required: ☐ Yes ☒ No

☐ House/Mod. Home ☒ Mobile Home ☐ Business ☐ Other

No. Bedrooms 4 No. Bathrooms 2 No. Employees


Water Supply: ☒ Individual ☐ Public ☐ Community

☐ Slab ☒ Crawl Space ☐ Basement w/plumbing ☐ Basement wo/plumbing


Comments:/Conditions:

Comments:/Conditions:

INITIAL SITE SKETCH

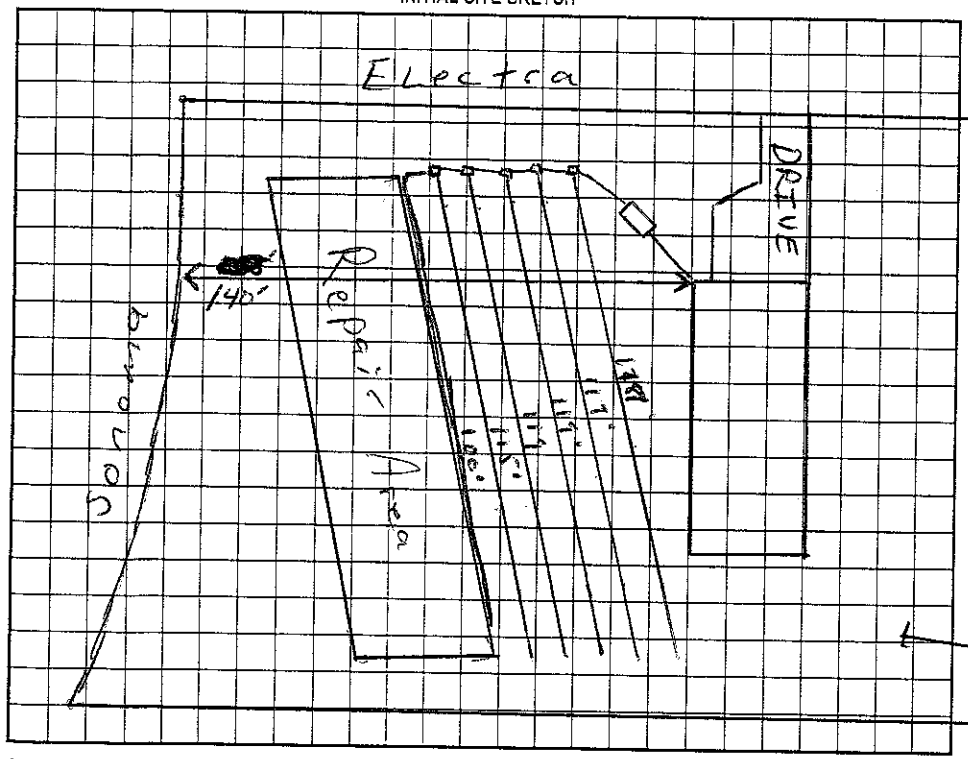

AS BUILT SKETCH

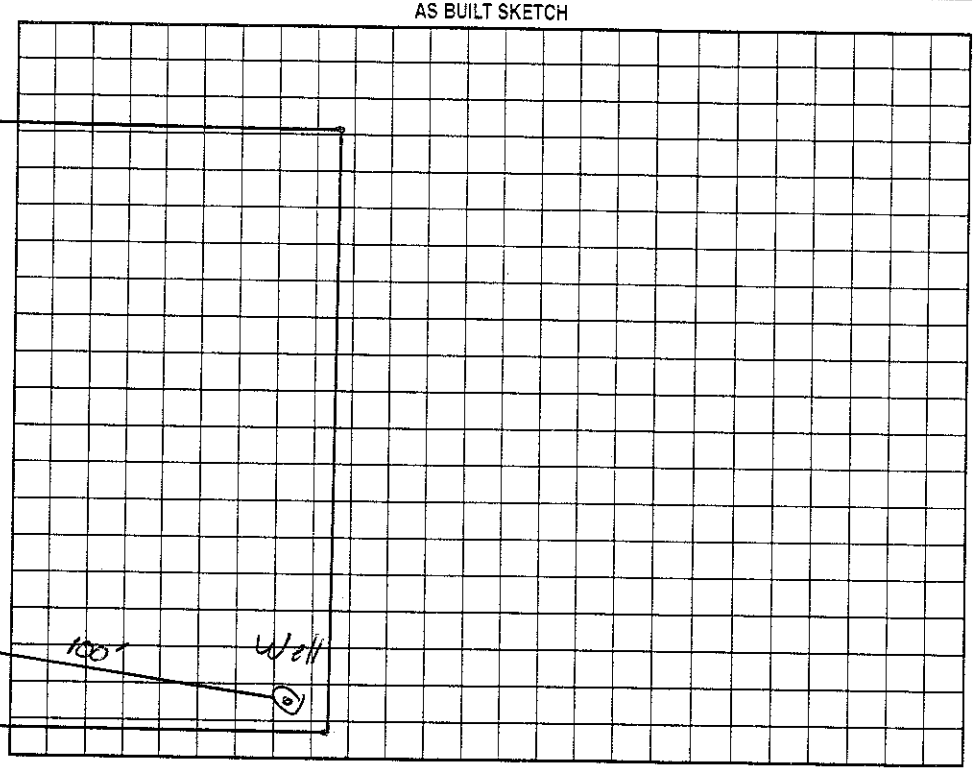

Permit can be suspended or revoked if any false information is supplied toward securing the permit/any unauthorized changes are made to the site/any unauthorized changes are made in the installation of the system. Improvement Permit with plat valid without expiration. Improvement Permit with site plan valid for sixty months. Authorization to Construct is valid for a period equal to that of Improvement Permit – not to exceed sixty months.

Signed: Jane B Carson date 2/28/02 Installed by: Craig Thompson

Improvement Permit by: RS date 1/17/02 Operation Permit by: Wesley Sparks R.S. date 3/28/02

Authorization to Construct by: RS date 1/17/02 Existing System Inspection by: date

HEALTH DEPT. COPY: WHITE OWNER COPY (FINAL): YELLOW OWNER COPY (INITIAL): PINK