IREDELL COUNTY HEALTH DEPARTMENT

STATESVILLE 704-878-5305 MOORESVILLE 704-664-5281

IMPROVEMENT PERMIT / AUTHORIZATION TO CONSTRUCT / OPERATION PERMIT / EXISTING SYSTEM INSPECTION

PERMIT# 86594 PIN# ~~4760466477PT~~ 4760958116 DATE 3/15/00

OWNER OR CONTRACTOR OVERCASH LAND & DEV. PHONE: Business 528-2529 Home

ADDRESS PO Box 3546 MOORESVILLE NC 28117

LOCATION 115N - TR SHINVILLE RD - TL SONOMA - 2nd ON LT

SUBDIVISION SHINVILLE EST. BLOCK / SECTION I LOT 2 LOT AREA 1.08 AC SITE CLASS. PS DESIGN FLOW 360 GPD L.T.A.R. 36 GPD/FT²

Septic Tank: 1000 Gallons; STB 825 Date 4/20/00

Pump Tank: Gallons; PT Date

Pump Make: Model Serial No.

Nitrification Field: No Fields 1 Square Feet 1200 Linear Feet 400

No Lines 4@100' Trench Width 36" Max Trench Bottom Depth 36" Gravel Depth 12"

☑ New System ☐ Repair System Type: I, II, III, IV, V, VI

System Description: GRAVITY CONVENTIONAL

Repair System Description: SAME/INNOVATIVE

Maintenance Agreement Required: ☐ Yes ☑ No

☐ House/Mod. Home ☑ Mobile Home ☐ Business ☐ Other

No. Bedrooms 3 No. Bathrooms 2 No. Employees


☐ Slab ☑ Crawl Space ☐ Basement w/plumbing ☐ Basement wo/plumbing

Water Supply: ☑ Individual ☐ Public ☐ Community


Comments/Conditions:

Comments/Conditions: * KEEP WELL 100' FROM SYSTEM *

INITIAL SITE SKETCH

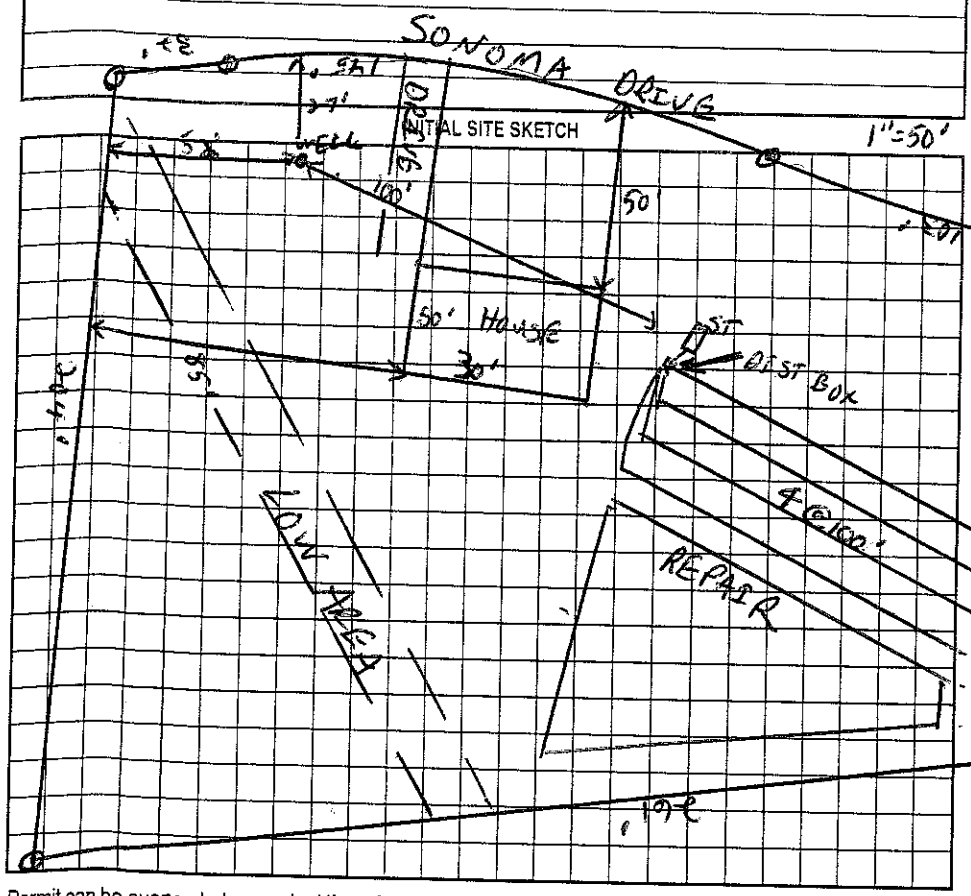

AS BUILT SKETCH

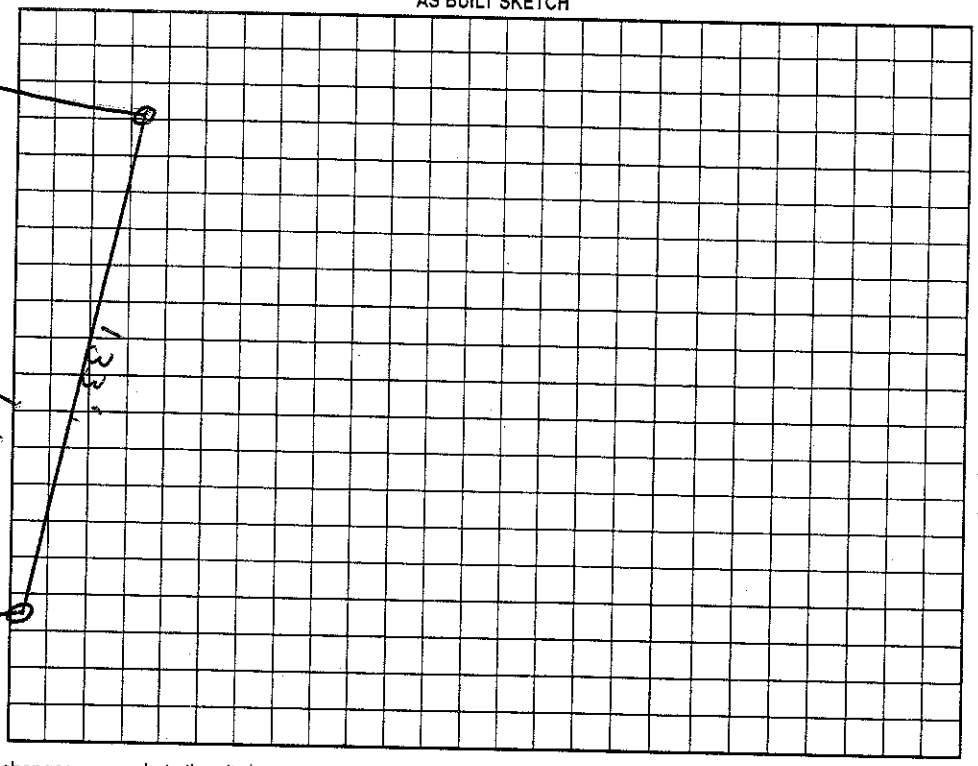

Permit can be suspended or revoked if any false information is supplied toward securing the permit/any unauthorized changes are made to the site/any unauthorized changes are made in the installation of the system. Improvement Permit with plat valid without expiration. Improvement Permit with site plan valid for sixty months. Authorization to Construct is valid for a period equal to that of Improvement Permit – not to exceed sixty months.

Signed: [signature] date

Improvement Permit by: [signature] RS date 3/15/00

Authorization to Construct by: Wesley Sparks RS. date 7/25/00

Installed by: Upright Septic Tank + Grading

Operation Permit by: Wesley Sparks RS. date 8/8/00

Existing System Inspection by: date

HEALTH DEPT. COPY: WHITE OWNER COPY (FINAL): YELLOW OWNER COPY (INITIAL): PINK