IREDELL COUNTY HEALTH DEPARTMENT

Statesville Office (704) 878-5305 Mooresville Office (704) 660-3625 MO PERMIT # 218906

IMPROVEMENT PERMIT / AUTHORIZATION TO CONSTRUCT / OPERATION PERMIT / EXISTING SYSTEM

PIN # 4760-95-8116

APPLICANT: Matthew VOLRATH APPLICANT ADDRESS: 135 Sonoma Dr., Cleveland, 27013

SITE ADDRESS: 135 Sonoma Dr. - Cleveland PHONE: 704-326-6849 ALT. PHONE:

SITE DIRECTIONS: Hwy 115 N, TR Shinnville, TL Sonoma, 2nd lot on L

SUBDIVISION: Shinnville Estate's SECTION: 1 LOT # 2 LOT AREA: 1.085 ac DESIGN FLOW: 360 gpd L.T.A.R.:

Septic Tank 1000 EX (gal) STB Date

Pump Tank (gal) PT Date

Pump Make Model Serial #

Nitrification Fields EX # Lines 4 Ex. Linear Ft: Ex.

Trench Width Ex Max. Trench Bottom Depth Ex. Gravel Depth Ex.

☐ New System ☐ Repair ☐ Expansion System Type: I II III IV V VI

System Description: Ex. Gravity Gravel

Repair System Description:

Maintenance Agreement Required: ☐ YES ☑ NO

☑ GRAVITY ☐ PRESSURE

☐ Residence No. Bedrooms 3

☐ Business No. Persons 6

☑ Other Garage No. Employees

☐ Slab ☐ Crawl Space


☐ Basement w/plumbing ☐ Basement w/o plumbing

Water Supply: ☑ Private Ex. ☐ Public ☐ Community


Comments / Conditions:

*This permit is for the addition of a 28'x28' Garage only *

INITIAL SITE SKETCH

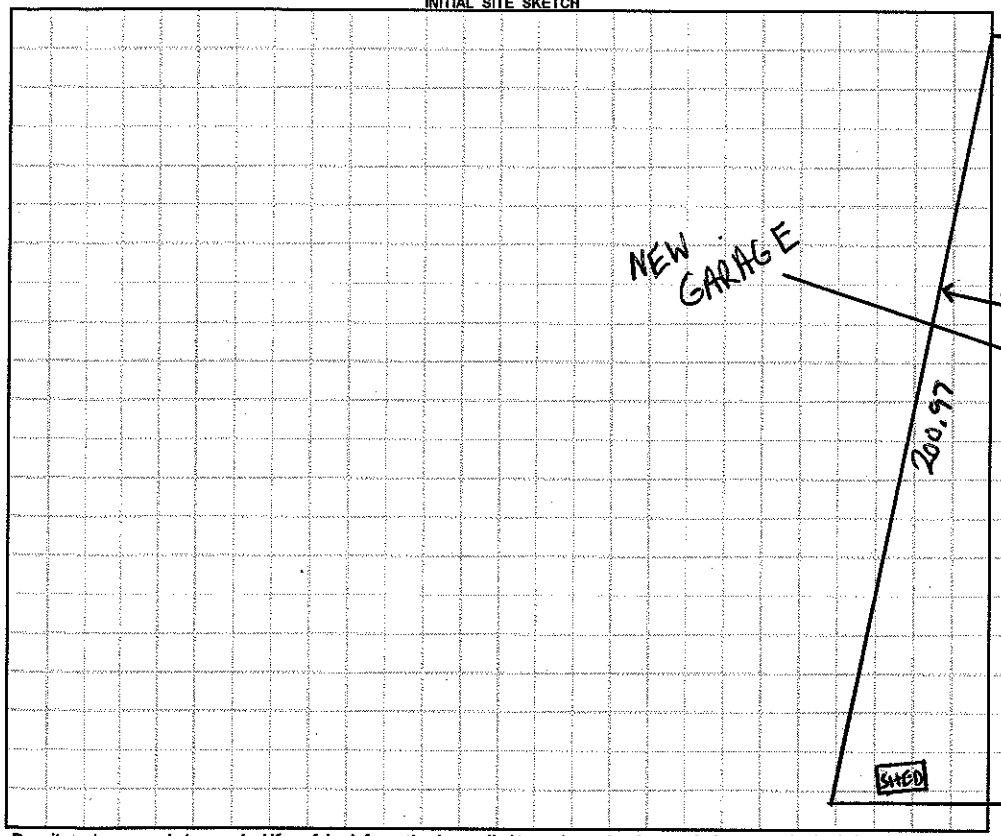

AS BUILT SKETCH

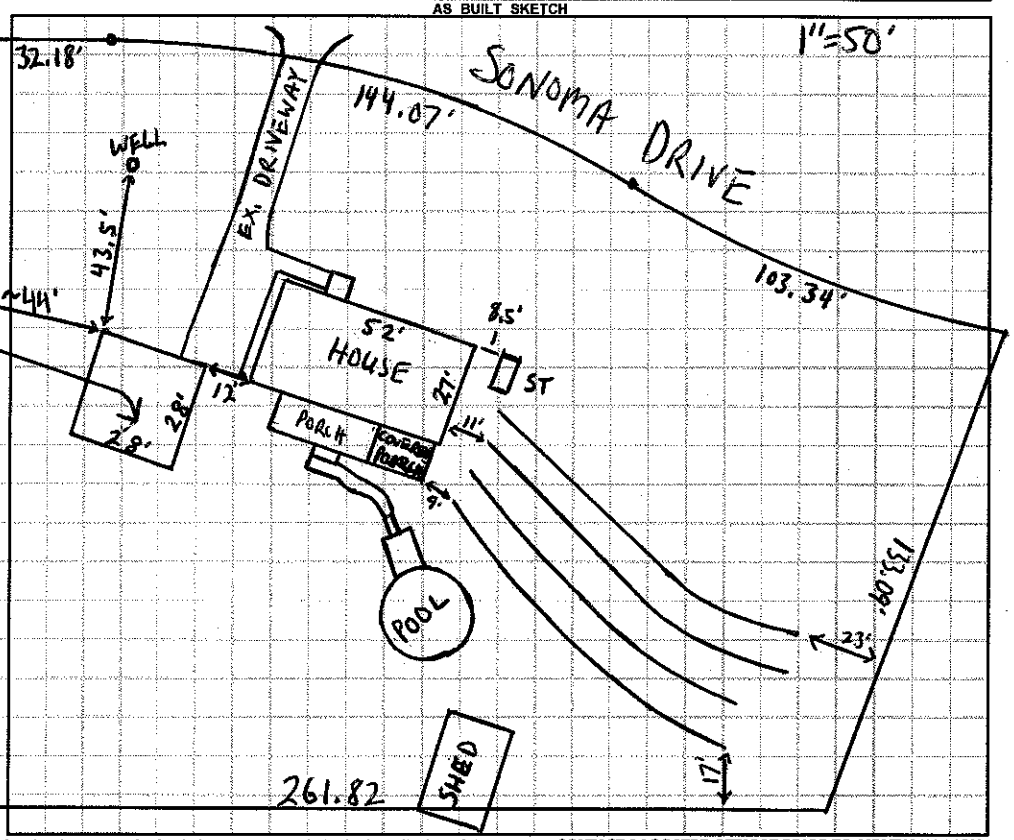

Permit can be suspended or revoked if any false information is supplied toward securing the permit / any unauthorized changes are made to the site / any unauthorized changes are made in the installation of the system. **CONTACT A LOCATOR SERVICE PRIOR TO ANY EXCAVATION**

☐ **IMPROVEMENT PERMIT** *with plat valid without expiration.* ☐ **IMPROVEMENT PERMIT** *with site plan valid for 60 mos.* ☐ **AUTHORIZATION TO CONSTRUCT** *valid for period equal to IMPROVEMENT PERMIT--not to exceed 60 mo.*

Owner / Applicant Signature: Marie Vallrath Date: 6-23-16 Installed by:

IMPROVEMENT PERMIT by: Date: OPERATION PERMIT by: Date:

AUTHORIZATION TO CONSTRUCT by: Date: Existing System Inspected by: Date: 6-23-16

Health Dept. Copy - WHITE Applicant (Final Approval) - YELLOW Applicant (Conditional Approval) - PINK