IREDELL COUNTY HEALTH DEPARTMENT

STATESVILLE 704-878-5305 [X] MOORESVILLE 704-664-5281

IMPROVEMENT PERMIT / AUTHORIZATION TO CONSTRUCT / OPERATION PERMIT / EXISTING SYSTEM INSPECTION

PERMIT # 17338 PIN # 4760-95-8851 DATE 7-3-12

OWNER or APPLICANT ERIC WARD PHONE: Business 704-883-6148 Home:

OWNER or APPLICANT ADDRESS 1124 CHARLOTTE HWY

LOCATION / DIRECTIONS SHINNVILLE, TL SONOMA, TR ELECTRA, ON R

SUBDIVISION SHINNVILLE ESTATES BLOCK / SECTION LOT # 17 LOT AREA 1.038 DESIGN FLOW 360 L.T.A.R. .3

Septic Tank 1000 Gallons: STB 760 Date 2-9-12
Pump Tank Gallons: PT Date
Pump Make Model Serial #
Nitrification Field No Fields 1 No Lines 4 Linear Feet 300'
Trench Width 36" Max. Trench Bottom Depth 36" Gravel Depth —

[X] New System [ ] Repair [ ] Expansion System Type I II (III) IV V VI
System Description: G - 25% REDUCTION
Repair System Description: PM - 25%
Maintenance Agreement Required [ ] YES [X] NO
[X] GRAVITY [ ] PRESSURE


[X] Residence No. Bedrooms 3
[ ] Business No. Persons
[ ] Other No. Employees
[ ] Slab [X] Crawl Space
[ ] Basement w/plumbing [ ] Basement w/o plumbing

Water Supply: [X] Private [ ] Public [ ] Community


Comments / Conditions: ① LEAVE ROOM FOR WELL IN FRONT RIGHT CORNER

Comments / Conditions

INITIAL SITE SKETCH

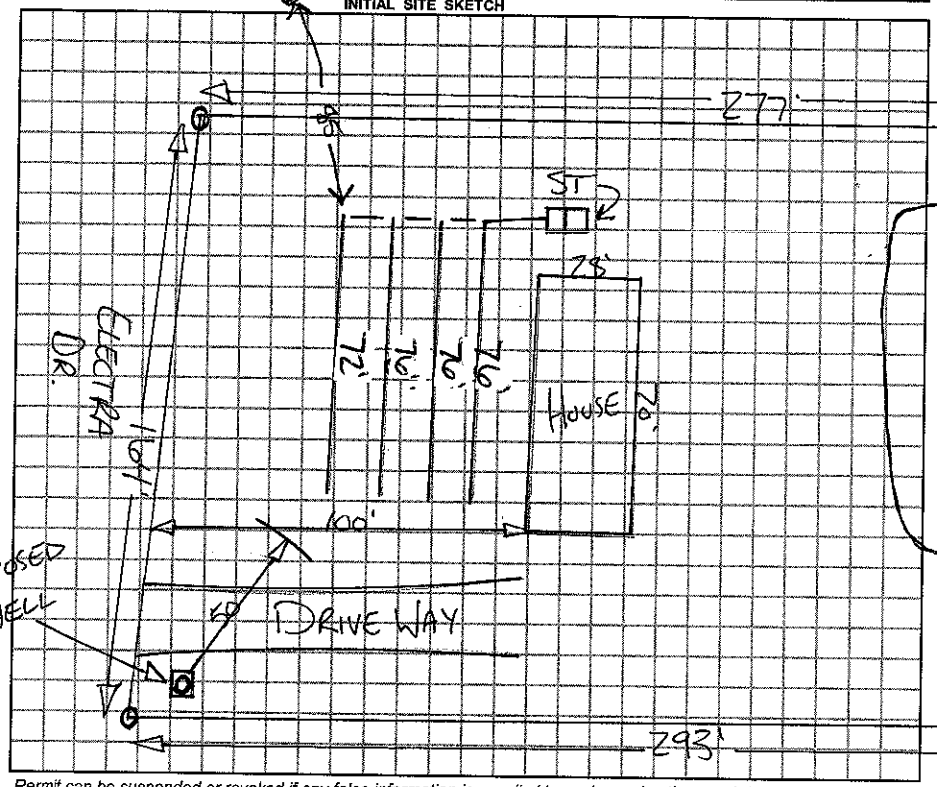

AS BUILT SKETCH

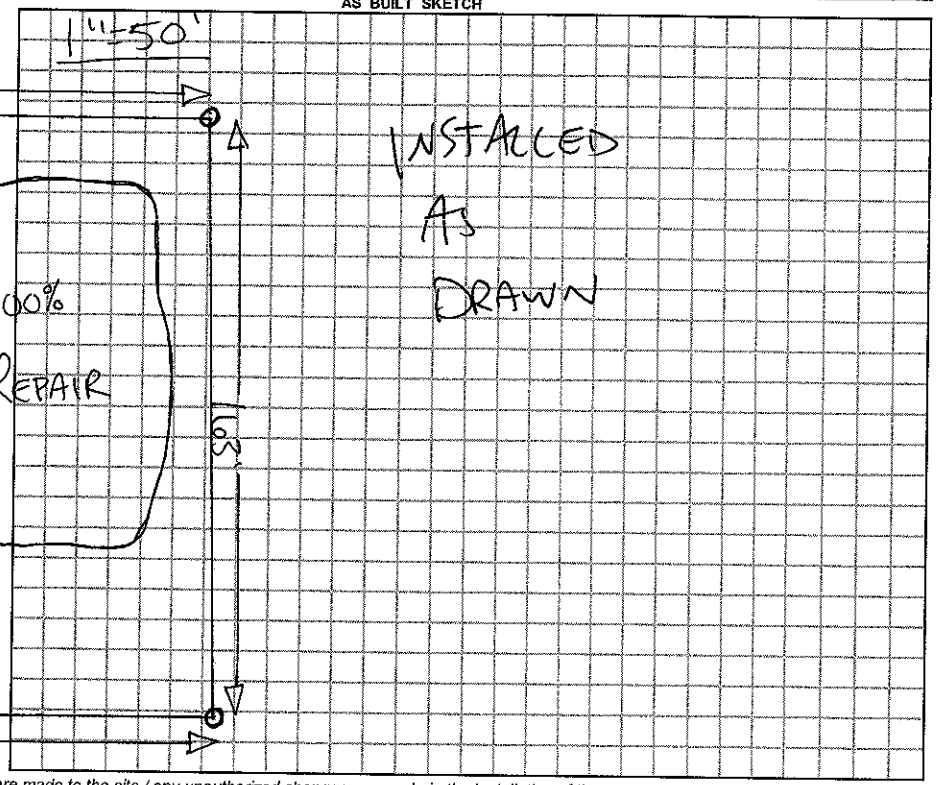

Permit can be suspended or revoked if any false information is supplied toward securing the permit / any unauthorized changes are made to the site / any unauthorized changes are made in the installation of the system.

[ ] *IMPROVEMENT PERMIT w / plat valid without expiration.* [ ] *IMPROVEMENT PERMIT w / site plan valid for 60 mos.* [X] *AUTHORIZATION TO CONSTRUCT valid for period equal to IMPROVEMENT PERMIT-not to exceed 60 mo.*

Owner / Applicant Signature: Eric Ward Date 7-5-12

Improvement Permit by: RA REHS Date 7-3-12

Authorization to Construct by: RA REHS Date 7-3-12

YOU SHOULD CONTACT A LOCATOR SERVICE PRIOR TO ANY EXCAVATION.

Installed by: A-1

Operation Permit by: RA REHS Date: 7-10-12

Existing System Inspected by: Date:

WHITE COPY Environmental Health YELLOW COPY (Final) Owner / Applicant PINK COPY (Initial) Owner / Applicant