IREDELL COUNTY HEALTH DEPARTMENT

Statesville Office (704) 878-5305 Mooresville Office (704) 660-3625 PERMIT # 205235

IMPROVEMENT PERMIT / AUTHORIZATION TO CONSTRUCT / OPERATION PERMIT / EXISTING SYSTEM

PIN # 4760-96-~~3019~~ 2299

APPLICANT: Raymond Erwin APPLICANT ADDRESS: 132 Nuthatch Dr Cleveland, NC 27013

SITE ADDRESS: 132 Nuthatch Dr Cleveland NC PHONE: (215) 356 3205 ALT. PHONE:

SITE DIRECTIONS: Go Hwy 21 N TR on Shinnville TL on Sonoma TR on Nuthatch 1st on end of cul de sac on right

SUBDIVISION: Shinnville Est SECTION: 3 LOT # 34 LOT AREA: 2.832ac DESIGN FLOW: 360 L.T.A.R.:

Septic Tank 1000 existing (gal) STB Date
Pump Tank (gal) PT Date
Pump Make Model Serial #
Nitrification Fields 1 # Lines 4 - 75' existing Linear Ft: 300'
Trench Width Max. Trench Bottom Depth Gravel Depth


☐ New System ☐ Repair ☐ Expansion System Type: I (II) III IV V VI
System Description: existing
Repair System Description: 25% reduction gravity
Maintenance Agreement Required: ☐ YES ☑ NO
☑ GRAVITY ☐ PRESSURE

☒ Residence No. Bedrooms 3
☐ Business No. Persons
☑ Other No. Employees
☑ Slab ☐ Crawl Space
☐ Basement w/plumbing ☐ Basement w/o plumbing


Water Supply
☑ Private existing
☐ Public
☐ Community

Comments / Conditions: This permit is for an accessory bldg only. No additions of bedrooms above 3 or 360 gpd. New bldg not to be inhabited. No expansion to septic system.

INITIAL SITE SKETCH

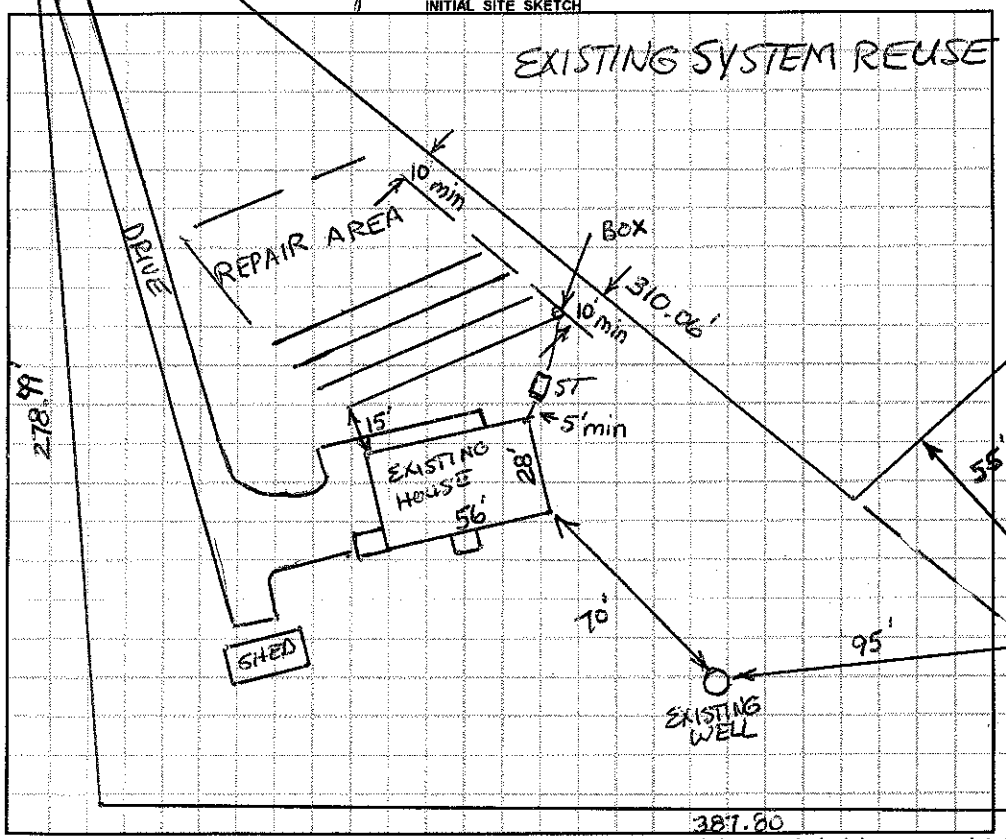

AS BUILT SKETCH

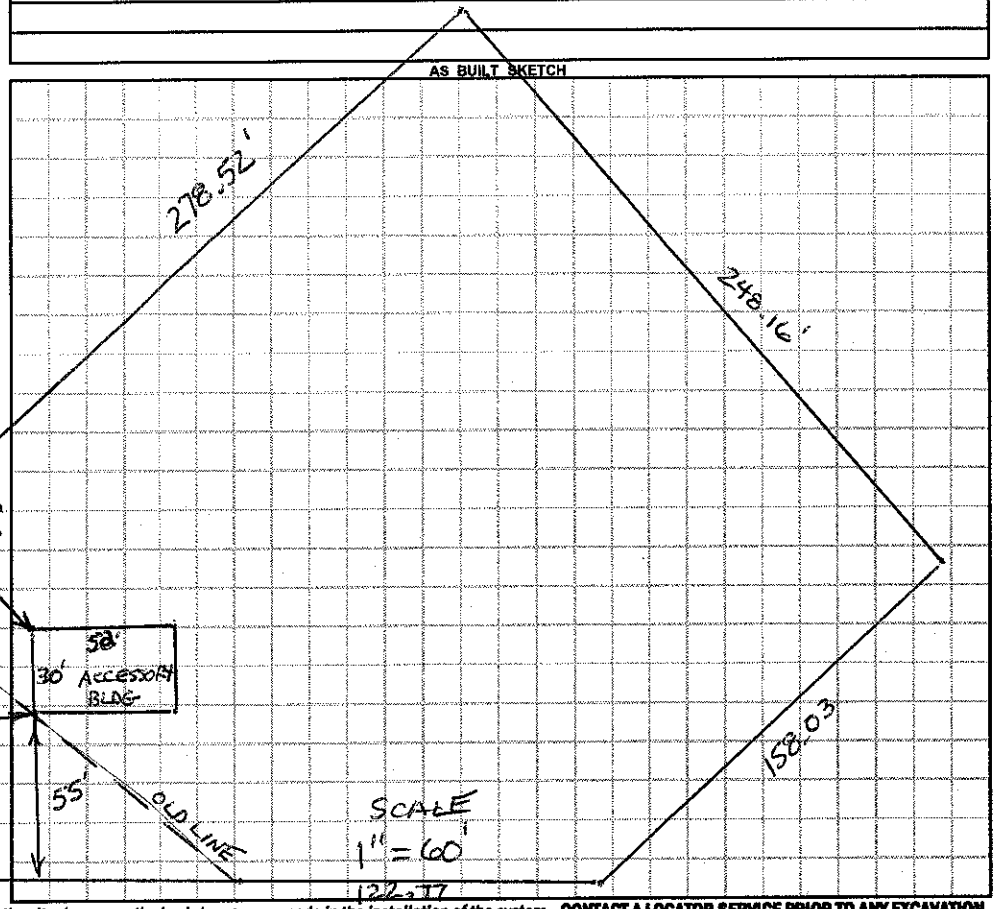

Permit can be suspended or revoked if any false information is supplied toward securing the permit / any unauthorized changes are made to the site / any unauthorized changes are made in the installation of the system. **CONTACT A LOCATOR SERVICE PRIOR TO ANY EXCAVATION**

☐ **IMPROVEMENT** *valid for 60 mos.* ☐ **AUTHORIZATION TO CONSTRUCT** *valid for period equal to IMPROVEMENT PERMIT--not to exceed 60 mo.*

Location of the proposed accessory bldg addition does not appear to impact the existing on-site septic system or well.**NOTE:

Owner / Applicant

IMPROVEMENT PE Richard Farris REHS Date: 10/10/14

AUTHORIZATION TI ICHD-Environmental Health Division

Installed by:

/14 OPERATION PERMIT by: Date:

Existing System Inspected by: Date:

nal Approval) - YELLOW Applicant (Conditional Approval) - PINK