IREDELL COUNTY HEALTH DEPARTMENT - *ENVIRONMENTAL HEALTH* ☐ STATESVILLE OFFICE 704-878-5305 ☒ MOORESVILLE OFFICE 704-664-5281

IMPROVEMENT PERMIT / AUTHORIZATION TO CONSTRUCT / OPERATION PERMIT / EXISTING SYSTEM INSPECTION

PERMIT # 168438 PIN # 4760-96-5031 DATE 9-12-11

OWNER Tommy White APPLICANT: Same PHONE: Home/Cell # 704-883-2440 ~~Business #~~ → Eric Ward

SITE ADDRESS 000 Electra Dr OWNER / APPLICANT ADDRESS Same

SITE DIRECTIONS 21N, TR Shinnville, TL into Shinnville Est, TR Electra, (L)

SUBDIVISION Shinnville Estates BLOCK / SECTION LOT # 25 & 26 LOT AREA 1.908 DESIGN FLOW 360 L.T.A.R. .3

Septic Tank 1000 Gallons: STB 760 Date 4-24
Pump Tank Gallons: P T Date
Pump Make Model Serial #
No. Nitrification Fields: 1 No. Lines 3 Linear Feet 300'
Trench Width 36" Max. Trench Bottom Depth 36" Gravel Depth ——


☒ New System ☐ Repair ☐ Expansion System Type I II (III) IV V VI
System Description: G 25% Reduction
Repair System Description: PM - 25% Reduction
Maintenance Agreement Required ☐ YES ☒ NO
☒ GRAVITY ☐ PRESSURE

☒ Residence No. Bedrooms 3
☐ Business No. Persons
☐ Other No. Employees
☐ Slab ☒ Crawl Space
☐ Basement w/plumbing ☐ Basement w/o plumbing

Water Supply
☒ Private
☐ Public
☐ Community

Comments / Conditions

INITIAL SITE SKETCH AS BUILT SKETCH

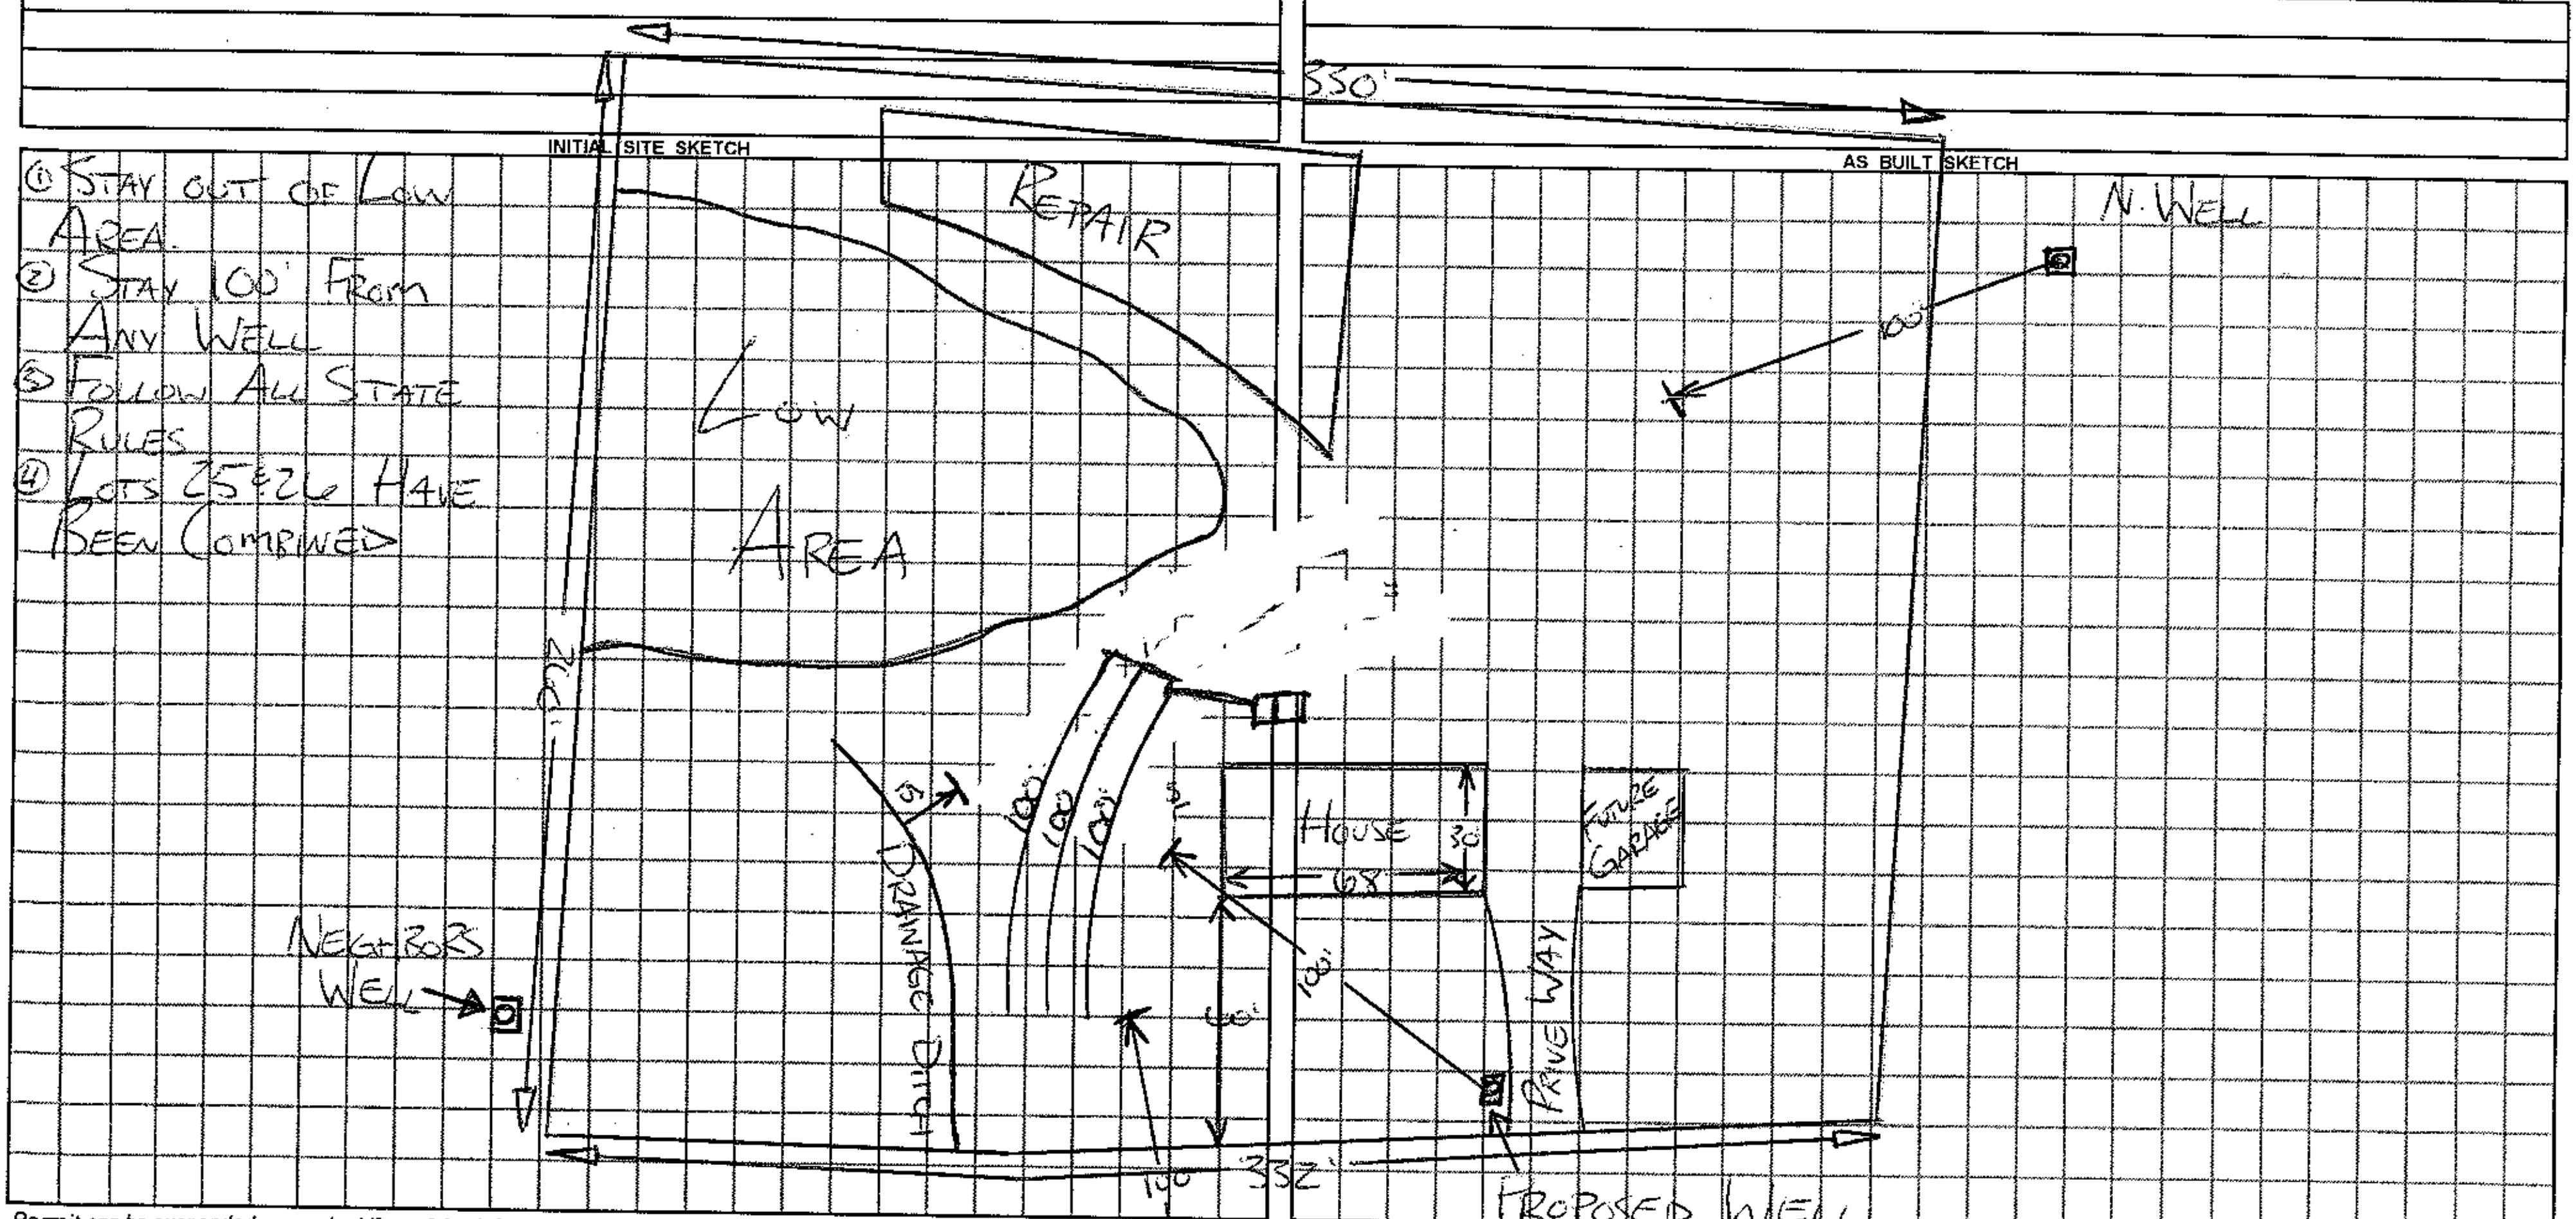

Permit can be suspended or revoked if any false information is supplied toward securing the permit / any unauthorized changes are made to the site / any unauthorized changes are made in the installation of the system.

☐ **IMPROVEMENT PERMIT** *with plat valid without expiration.* ☐ **IMPROVEMENT PERMIT** *with site plan valid 60 mo.* ☒ **AUTHORIZATION TO CONSTRUCT** valid for period equal to IMPROVEMENT PERMIT--not to exceed 60 mo.

Owner / Applicant Signature: Eric Ward Date 9-13-11 Installed by: A-1

IMPROVEMENT PERMIT by: [signature] **REHS** Date 9-12-11 OPERATION PERMIT by: [signature] **REHS** Date

AUTHORIZATION TO CONSTRUCT by: [signature] **REHS** Date 9-12-11 Existing System Inspected by: **REHS** Date

YOU SHOULD CONTACT A LOCATOR SERVICE PRIOR TO ANY EXCAVATION

NE Well

...mental Health YELLOW COPY (Final) Owner / Applicant PINK COPY (Initial) Owner / Applicant