IREDELL COUNTY HEALTH DEPARTMENT

STATESVILLE 704-878-5305 MOORESVILLE 704-664-5281

2100

IMPROVEMENT PERMIT / AUTHORIZATION TO CONSTRUCT / OPERATION PERMIT / EXISTING SYSTEM INSPECTION

PERMIT # 112380/160102 PIN # 4760961256 DATE 3-11-2010

OWNER or APPLICANT Spear Construction PHONE: Business 704 636-7954 Home: Cell 704 361 7518

OWNER or APPLICANT ADDRESS 607 Anderson Ave, Salisbury, NC 28144

LOCATION / DIRECTIONS Hwy 115/21 TR Shinnville Rd TL Sonoma Drive TR Electra Drive on left

SUBDIVISION Shinnville Est. BLOCK / SECTION LOT # 24 LOT AREA 1.135Ac DESIGN FLOW 480gpd L.T.A.R. .25

Septic Tank 1000 Gallons: STB 825 Date 6-20-10

Pump Tank Gallons: PT Date

Pump Make Model Serial #

Nitrification Field No Fields 2 No Lines 3+3 Linear Feet 480'

Trench Width 36" Max. Trench Bottom Depth 36" Gravel Depth N/A

☒ New System ☐ Repair ☐ Expansion System Type I (II) III IV V VI

System Description: Gravity - 25% Reduction

Repair System Description: Pump - 25-50% Reduction

Maintenance Agreement Required ☐ YES ☒ NO

☒ GRAVITY ☐ PRESSURE

☒ Residence No. Bedrooms 4

☐ Business No. Persons

☐ Other No. Employees


☐ Slab ☐ Crawl Space

☐ Basement w/plumbing ☐ Basement w/o plumbing

Water Supply: ☐ Private ☐ Public ☐ Community

Comments / Conditions

Scale 1:50

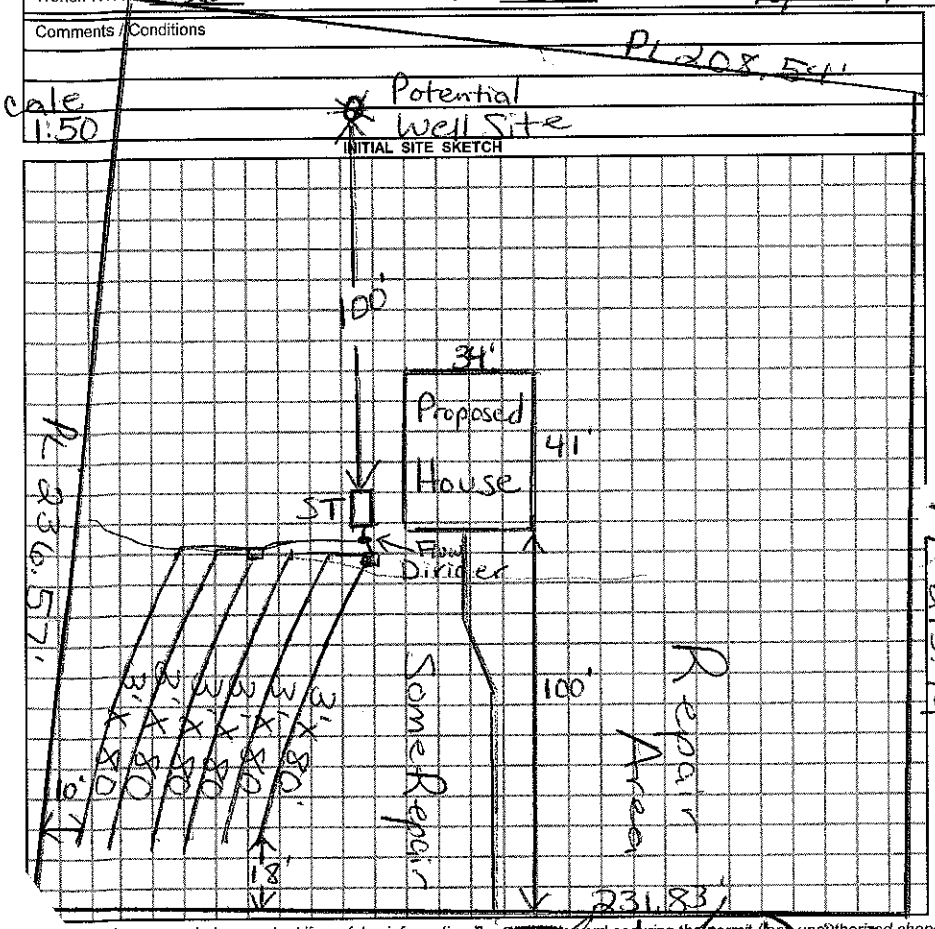

INITIAL SITE SKETCH

Comments / Conditions Keep DrainField at least 100ft From any well, 10ft From PL & 15ft From Road Cut & Divert Stormwater Away From DrainField

AS BUILT SKETCH

Installed "Quick 4" Essentially as Shown

It can be suspended or revoked if any false information is supplied toward securing the permit / any unauthorized changes are made to the site / any unauthorized changes are made in the installation of the system.

☐ IMPROVEMENT PERMIT w / plat valid without expiration. ☐ IMPROVEMENT PERMIT w / site plan valid for 60 mos. ☐ AUTHORIZATION TO CONSTRUCT valid for period equal to IMPROVEMENT PERMIT-not to exceed 60 mo.

Applicant Signature: Date 3-11-10

Permit by: Date 3/11/2010

Construct by: Date 3/11/2010

Installed by: Rowan Septic REHS Date: 8/2/2010

Operation Permit by: Date:

Existing System Inspected by: Date:

CONTACT A LOCATOR SERVICE PRIOR TO ANY EXCAVATION.

WHITE COPY Environmental Health YELLOW COPY (Final) Owner / Applicant PINK COPY (Initial) Owner / Applicant