10.15

IREDELL COUNTY HEALTH DEPARTMENT

STATESVILLE 704-878-5305 MOORESVILLE 704-664-5281

IMPROVEMENT PERMIT / AUTHORIZATION TO CONSTRUCT / OPERATION PERMIT / EXISTING SYSTEM INSPECTION

PERMIT# Repair PIN#

OWNER OR CONTRACTOR Devin Slade PHONE: Business Home DATE 3/16/05

ADDRESS 168 Turnberry Ln Mooresville NC 28117

LOCATION BSA TL Candlestick TL Turnberry Lan Rt on #115

SUBDIVISION St. Andrews BLOCK / SECTION LOT 23 LOT AREA SITE CLASS PS DESIGN FLOW 360 L.T.A.R.

Septic Tank: Existing Gallons: STB Date

Pump Tank: Gallons: PT Date

Pump Make: Model Serial No.

Nitrification Field: No Fields 1 Square Feet 400 Linear Feet 300

No Lines 30/100' Trench Width 36" Max Trench Bottom Depth 36" Gravel Depth —

☐ New System ☒ Repair System Type: I, II, (III), IV, V, VI

System Description:

Repair System Description: Gravity 25% Reduct

Maintenance Agreement Required: ☐ Yes ☒ No

☒ House/Mod. Home No. Bedrooms 3

☐ Mobile Home No. Bathrooms

☐ Business No. Employees

☐ Other


☐ Slab ☒ Crawl Space ☐ Basement w/plumbing ☐ Basement wo/plumbing

Water Supply: ☐ Individual ☐ Public ☒ Community


Comments/Conditions:

Comments/Conditions: Note: Repair Not done.

INITIAL SITE SKETCH

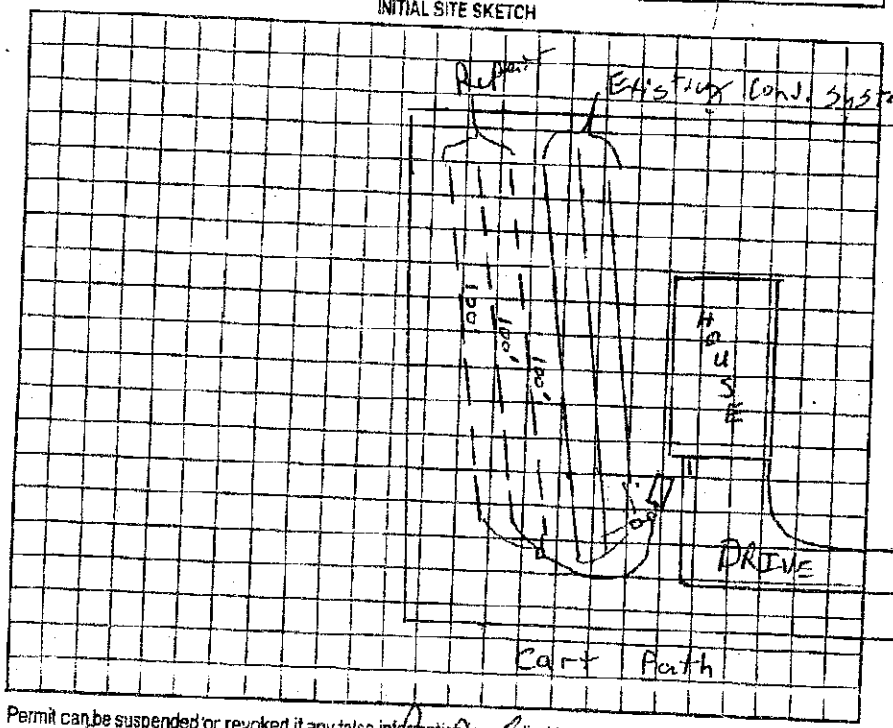

AS BUILT SKETCH

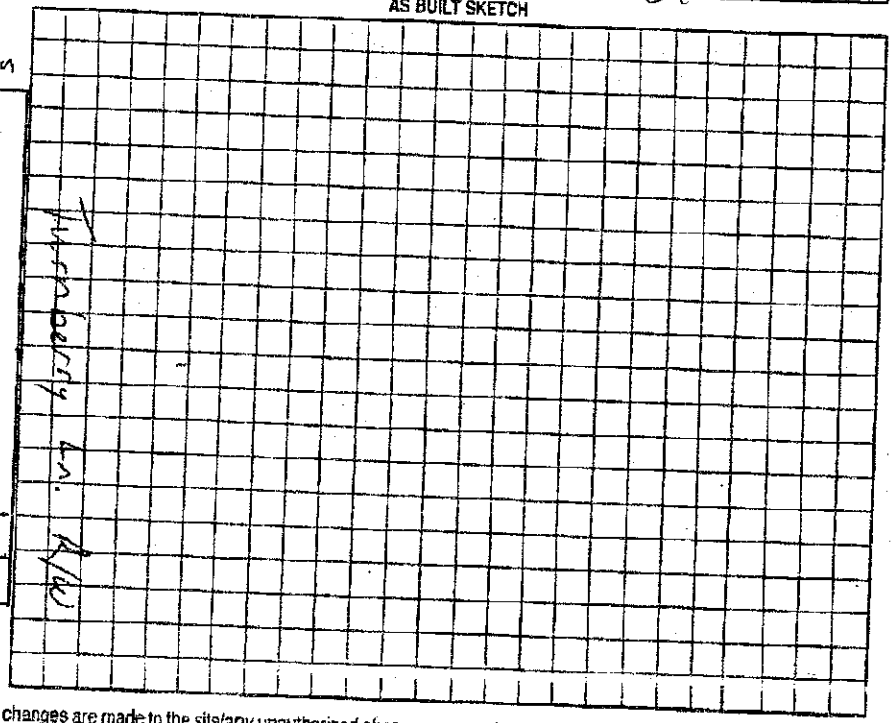

Permit can be suspended or revoked if any false information is supplied toward securing the permit/any unauthorized changes are made to the site/any unauthorized changes are made in the installation of the system. Improvement Permit with plat valid without expiration. Improvement Permit with site plan valid for sixty months. Authorization to Construct is valid for a period equal to that of Improvement Permit – not to exceed sixty months.

Signed: date 3-17-05 Installed by:

Improvement Permit by: RS date 3/16/05 Operation Permit by: date

Authorization to Construct by: RS date 3/16/05 Existing System Inspection by: date

HEALTH DEPT. COPY WHITE OWNER COPY (FINAL) YELLOW OWNER COPY (INITIAL) PINK

p.1 7046623490 Devin and Tammy Slade May 08 07 10:56a