IREDELL COUNTY HEALTH DEPARTMENT

STATESVILLE 704-878-5305

4760972982

MOORESVILLE 704-664-5281

IMPROVEMENT PERMIT / CERTIFICATE OF COMPLETION / OPERATION PERMIT / EXISTING SYSTEM INSPECTION

PROPERTY DESCRIPTION NO. 24557 DATE 8/13/96

OWNER OR CONTRACTOR Gregory L Murdock TAX MAP NO. 4I A 39

ADDRESS 167 Nachetown Cleveland, NC. 27013 PHONE: Business _____ Home 528-3028

LOCATION Shinnville Rd. TL Nachetown. 1st drive on (R) Watershed: ☐ Yes ☒ No

SUBDIVISION _____ BLOCK / SECTION _____ LOT _____ LOT AREA _____ SITE CLASS. _____ DESIGN FLOW _____ L.T.A.R. _____

Septic Tank: 1000 Gallons; STB _____ Date _____

Pump Tank: _____ Gallons; PT _____ Date _____

Pump Make: _____ Model _____ Serial No. _____

Nitrification Field: No Fields 1 Square Feet 300 Linear Feet 100

No Lines 1 Trench Width 36" Max Trench Bottom Depth 36" Gravel Depth 12"

☐ New System ☒ Repair System Type: I, (II), III, IV, V, VI

System Description: Add to Syst. from

Repair System Description: _____

Maintenance Agreement Required: ☐ Yes ☒ No

☐ House/Mod. Home ☒ Mobile Home ☐ Business ☐ Other

No. Bedrooms 3 No. Bathrooms 2.5 No. Employees _____


☐ Slab ☒ Crawl Space ☐ Basement w/plumbing ☐ Basement wo/plumbing

Water Supply: ☒ Individual ☐ Community ☐ Public

Comments: Add single 100' x 3' line to syst. from to reach 34¢ linear feet of absorption area.

Comments:

INITIAL SITE SKETCH

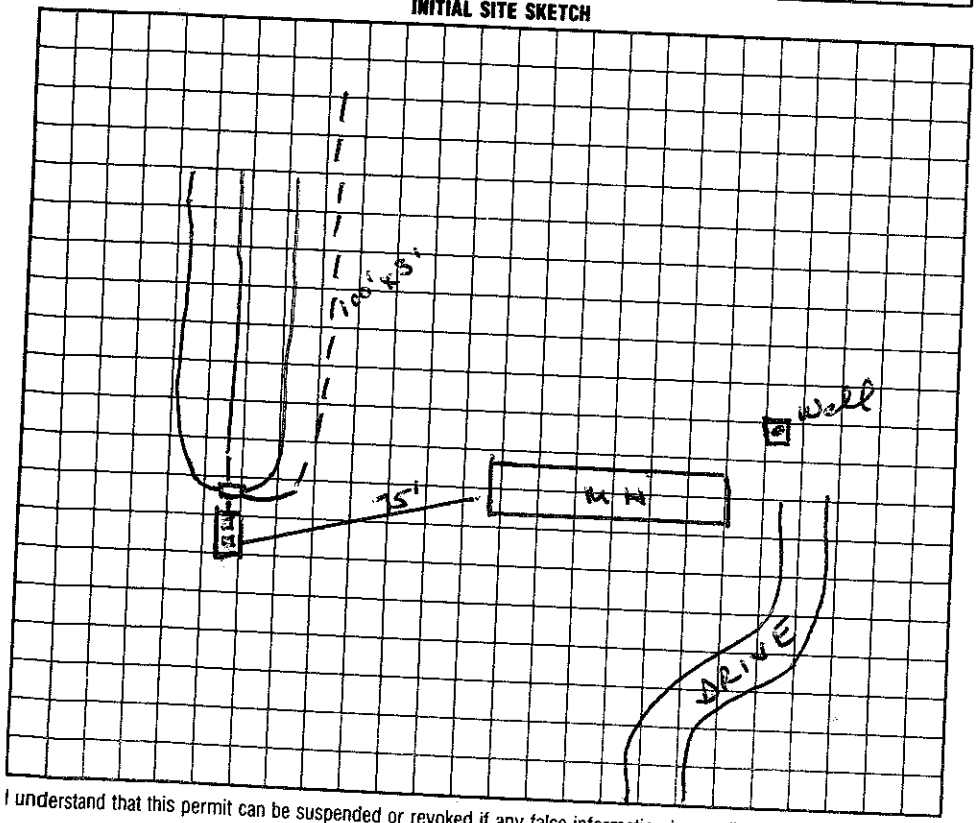

AS BUILT SKETCH

I understand that this permit can be suspended or revoked if any false information is supplied toward securing the permit/any unauthorized changes are made to the site/any unauthorized changes are made in the installation of the system.

Signed: _____

Improvement Permit by: Wesley Sparks RS. date 8/13/96

Existing System Inspection by: to Construct Wesley Sparks RS date 8/13/96

Installed by: Greg Murdock

Certificate of Completion by: _____ date _____

Operation Permit by: Wesley Sparks RS. date 8/19/96

HEALTH DEPT. COPY: WHITE INSPECTION COPY (FINAL): GREEN OWNER COPY (FINAL): YELLOW INSPECTION COPY (INITIAL): PINK OWNER COPY (INITIAL): GOLD