IREDELL COUNTY HEALTH DEPARTMENT

STATESVILLE 704-878-5305 MOORESVILLE 704-664-5281

IMPROVEMENT PERMIT / AUTHORIZATION TO CONSTRUCT / OPERATION PERMIT / EXISTING SYSTEM INSPECTION

-(200)

PERMIT# 078773 PIN# 4760977916 DATE 1/14/98

OWNER OR CONTRACTOR SANDRA BROWN PHONE: Business Home 528-3326

ADDRESS 25 PLAINS LN CLEVELAND 27013

LOCATION 115N-TR STATESVILLE-TL PLAINS LN 4th ON LT

SUBDIVISION BLOCK / SECTION LOT LOT AREA 2.04AC SITE CLASS. IS DESIGN FLOW 360 L.T.A.R. .00

Septic Tank: Gallons; STB Date

Pump Tank: Gallons; PT Date

Pump Make: Model EXISTING Serial No.

Nitrification Field: No Fields Square Feet Linear Feet

No Lines Trench Width Max Trench Bottom Depth Gravel Depth

☑ New System ☐ Repair System Type: I, II, III, IV, V, VI

System Description: CRAWL PANEL

Repair System Description: SOME

Maintenance Agreement Required: ☐ Yes ☑ No

☐ House/Mod. Home ☑ Mobile Home ☐ Business ☐ Other

No. Bedrooms 3 No. Bathrooms 2 No. Employees


☐ Slab ☑ Crawl Space ☐ Basement w/plumbing ☐ Basement wo/plumbing

Water Supply: ☑ Individual ☐ Public ☐ Community

Comments:/Conditions: ADD FILL MATERIAL AND CHANGE DIST. BOXES.

Comments:/Conditions:

INITIAL SITE SKETCH

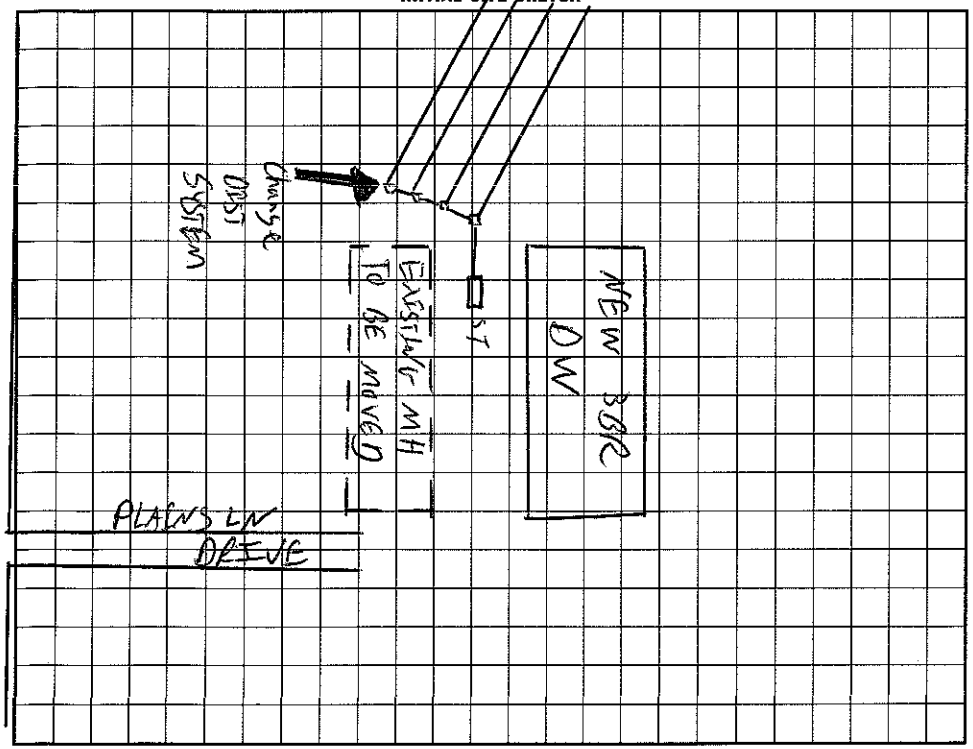

AS BUILT SKETCH

I understand that this permit can be suspended or revoked if any false information is supplied toward securing the permit/any unauthorized changes are made to the site/any unauthorized changes are made in the installation of the system. Improvement Permit with plat valid without expiration. Improvement Permit with site plan valid for sixty months. Authorization to Construct is valid for a period equal to that of Improvement Permit – not to exceed sixty months.

Signed: James Beeler date 1/14/99

Improvement Permit by: C. [illegible] date 1/14/98

Authorization to Construct by: C. [illegible] date 1/14/98

Installed by: A1 BACKHOE

Operation Permit by: C. [illegible] CS date 2/24/99

Existing System Inspection by: date

HEALTH DEPT. COPY: WHITE INSPECTION COPY (FINAL): GREEN OWNER COPY (FINAL): YELLOW INSPECTION COPY (INITIAL): PINK OWNER COPY (INITIAL): GOLD