IREDELL COUNTY HEALTH DEPARTMENT

STATESVILLE 704-878-5305 MOORESVILLE 704-664-5281

IMPROVEMENT PERMIT / AUTHORIZATION TO CONSTRUCT / OPERATION PERMIT / EXISTING SYSTEM INSPECTION

PERMIT# 078504 PIN# 4760978594 DATE 2/17/99

OWNER OR CONTRACTOR Margie Lancaster PHONE: Business Home 528-3894

ADDRESS 135 White Ridge Lane Cleveland NC. 28201

LOCATION Springwell Rd to White Ridge Lane to 4th on (L), only small house

SUBDIVISION Bowles/Talbert Est BLOCK / SECTION LOT 16 LOT AREA ~.5Ac SITE CLASS. 75 DESIGN FLOW 240 L.T.A.R.

Septic Tank: 1000 EXIST. Gallons; STB Date

Pump Tank: Gallons; PT Date

Pump Make: Model Serial No.

Nitrification Field: No Fields 1 Square Feet EXISTING Linear Feet SYSTEM

No Lines Trench Width P/L Max Trench Bottom Depth Gravel Depth

☐ New System ☐ Repair System Type: I, (II), III, IV, V, VI

System Description: EXISTING SYSTEM

Repair System Description:

Maintenance Agreement Required: ☐ Yes ☒ No

☒ House/Mod. Home No. Bedrooms 2

☐ Mobile Home No. Bathrooms 2

☐ Business No. Employees

☐ Other

☐ Slab ☒ Crawl Space ☐ Basement w/plumbing ☐ Basement wo/plumbing

Water Supply: ☒ Individual ☐ Public ☐ Community


Comments:/Conditions:

WELL

Comments:/Conditions:

Open Permit under John Nash - 1988 - Type II System

~~INITIAL SITE SKETCH~~ AS BUILT SKETCH

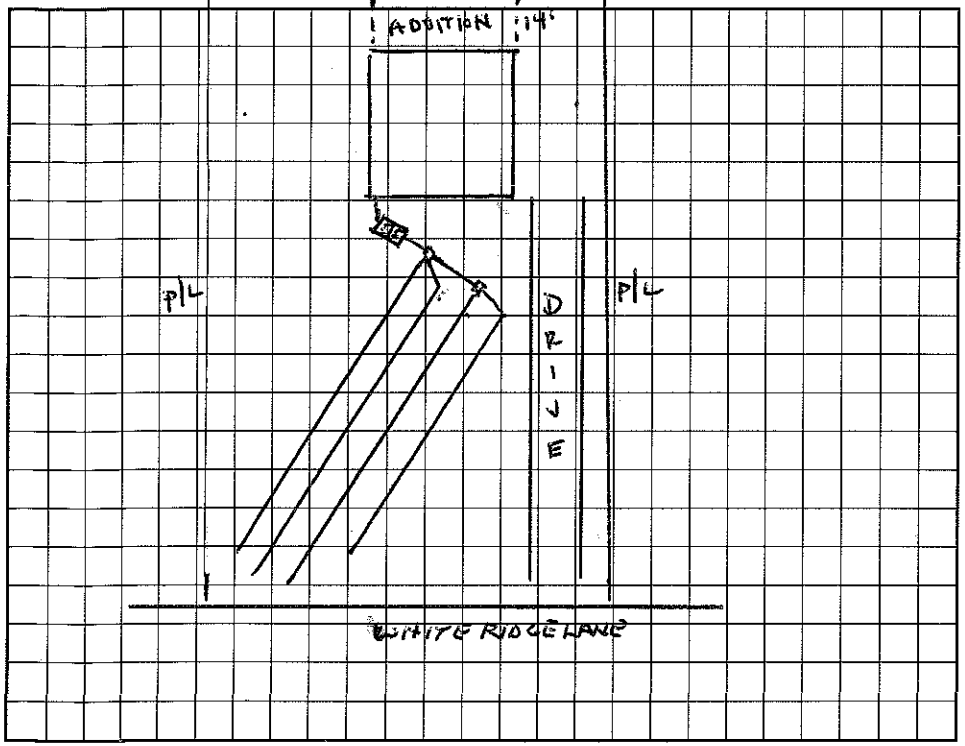

~~AS BUILT SKETCH~~

I understand that this permit can be suspended or revoked if any false information is supplied toward securing the permit/any unauthorized changes are made to the site/any unauthorized changes are made in the installation of the system. Improvement Permit with plat valid without expiration. Improvement Permit with site plan valid for sixty months. Authorization to Construct is valid for a period equal to that of Improvement Permit – not to exceed sixty months.

Signed: date

Improvement Permit by: date

Authorization to Construct by: date

Installed by:

Operation Permit by: date

Existing System Inspection by: Wesley Sparks RS. date 2/17/99

HEALTH DEPT. COPY: WHITE INSPECTION COPY (FINAL): GREEN OWNER COPY (FINAL): YELLOW INSPECTION COPY (INITIAL): PINK OWNER COPY (INITIAL): GOLD