IREDELL COUNTY HEALTH DEPARTMENT

STATESVILLE 704-878-5305 MOORESVILLE 704-664-5281

IMPROVEMENT PERMIT / AUTHORIZATION TO CONSTRUCT / OPERATION PERMIT / EXISTING SYSTEM INSPECTIO

PERMIT# 073712 PIN# 4760 97 9353

OWNER OR CONTRACTOR JOHNNIE N JONES PHONE: Business _____ DATE 6/22/98

ADDRESS PO BOX 39 . BARIUM SPRINGS NC 28010 Home 528-3393

LOCATION SHENDELLE RD - TL WHITE RIDGE LN - ON LT NEAT END

SUBDIVISION — BLOCK / SECTION — LOT — LOT AREA 1 99AC SITE CLASS. P5 DESIGN FLOW 360 L.T.A.R. —

Septic Tank: _____ Gallons; STB _____ Date _____

Pump Tank: _____ Gallons; PT EXISTING Date _____

Pump Make: _____ Model _____ Serial No. _____

Nitrification Field: No Fields ___ Square Feet _____ Linear Feet _____

No Lines _____ Trench Width _____ Max Trench Bottom Depth _____ Gravel Depth _____

☑ New System ☐ Repair System Type: I, II, III, IV, V, VI

System Description: GRAVITY CONVENTIONAL

Repair System Description: STUMP

Maintenance Agreement Required: ☐ Yes ☑ No

☐ House/Mod. Home No. Bedrooms 3

☑ Mobile Home No. Bathrooms 2

☐ Business No. Employees ___

☐ Other _____

☐ Slab ☑ Crawl Space ☐ Basement w/plumbing ☐ Basement wo/plumbing


Water Supply: ☑ Individual ☐ Public ☐ Community

Comments:/Conditions:

EXISTING SYSTEM

Comments:/Conditions:

INITIAL SITE SKETCH

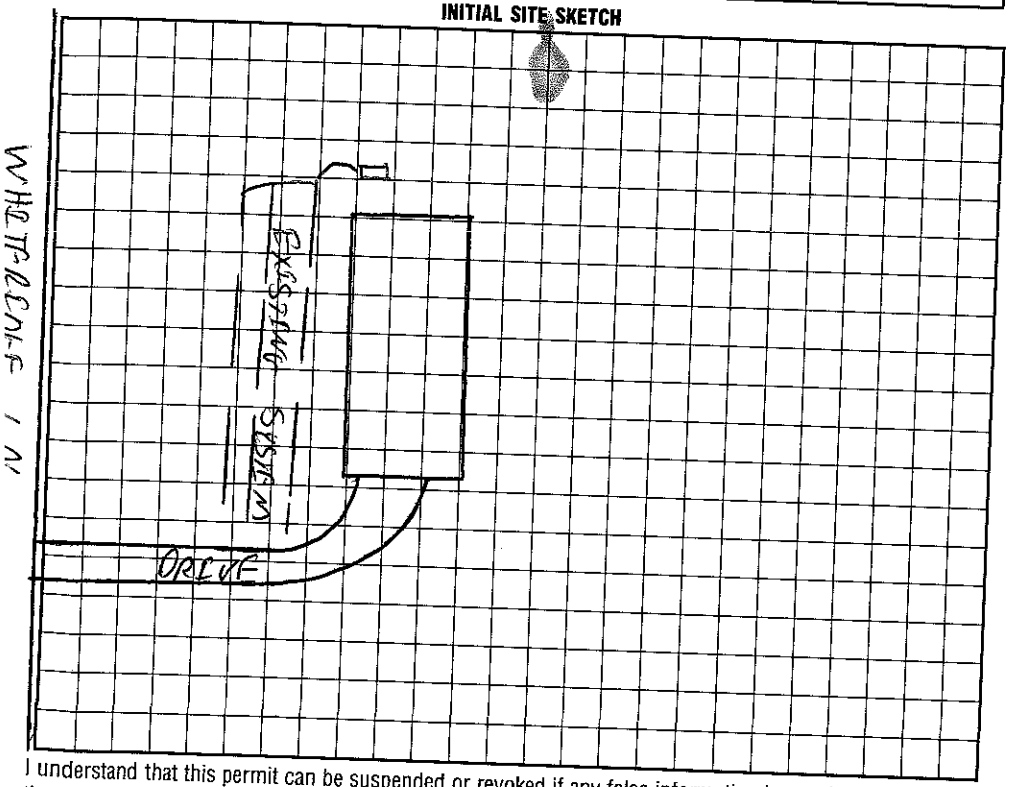

AS BUILT SKETCH

WHITE RIDGE LN

I understand that this permit can be suspended or revoked if any false information is supplied toward securing the permit/any unauthorized changes are made to the site/any unauthorized changes are made in the installation of the system. Improvement Permit with plat valid without expiration. Improvement Permit with site plan valid for sixty months. Authorization to Construct is valid for a period equal to that of Improvement Permit – not to exceed sixty months.

Signed: Johnnie N Jones

Improvement Permit by: _____ date 6-30-98

Authorization to Construct by: _____ date _____

Installed by: _____

Operation Permit by: _____ date _____

Existing System Inspection by: _____ date 6/22/98

HEALTH DEPT. COPY: WHITE INSPECTION COPY (FINAL): GREEN OWNER COPY (FINAL): YELLOW INSPECTION COPY (INITIAL): PINK OWNER COPY (INITIAL): GOLD