IREDELL COUNTY HEALTH DEPARTMENT

Statesville Office (704) 878-5305 Mooresville Office (704) 660-3625 PERMIT # 1766681

IMPROVEMENT PERMIT / AUTHORIZATION TO CONSTRUCT / OPERATION PERMIT / EXISTING SYSTEM

PIN # 4760-97-9966

APPLICANT: SANDRA BROWN APPLICANT ADDRESS: 115 PLAINS LN CLEVELAND, NC

SITE ADDRESS: SAME PHONE: 704-883-6148 ~~ALT. PHONE:~~ → ERIC WARD

SITE DIRECTIONS: 21N, SHINNVILLE, PLAINS, ON L


SUBDIVISION: JANAS COURT SECTION: LOT # 1 LOT AREA: .92 AC DESIGN FLOW: 360 L.T.A.R.: .3

Septic Tank	Ex. 1000 (gal)	STB	Date	☐ New System	☐ Repair	☒ Expansion	System Type: I II (III) IV V VI	☒ Residence	No. Bedrooms 3
Pump Tank	(gal)	PT	Date	System Description:		25% REDUCTION		☐ Business	No. Persons
Pump Make	Model		Serial #	Repair System Description:		SAME		☐ Other	No. Employees
# Nitrification Fields	1 # Lines	1 @ 100'	Linear Ft: 100'	Maintenance Agreement Required:	☐ YES	☒ NO		☐ Slab	☒ Crawl Space
Trench Width	36" Max. Trench Bottom Depth	36"	Gravel Depth		☒ GRAVITY	☐ PRESSURE		☐ Basement w/plumbing	☐ Basement w/o plumbing


Water Supply: ☐ Private ☐ Public ☒ Community

Comments / Conditions: INSTALL LINE @ 100'

INITIAL SITE SKETCH

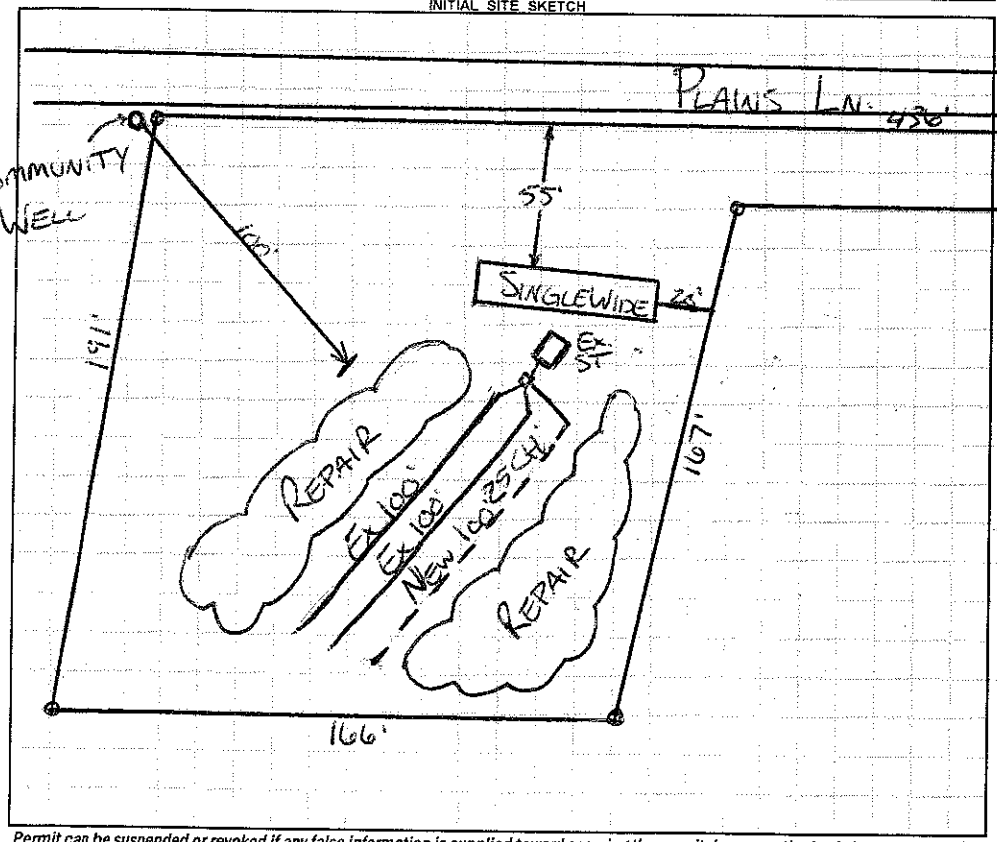

AS BUILT SKETCH

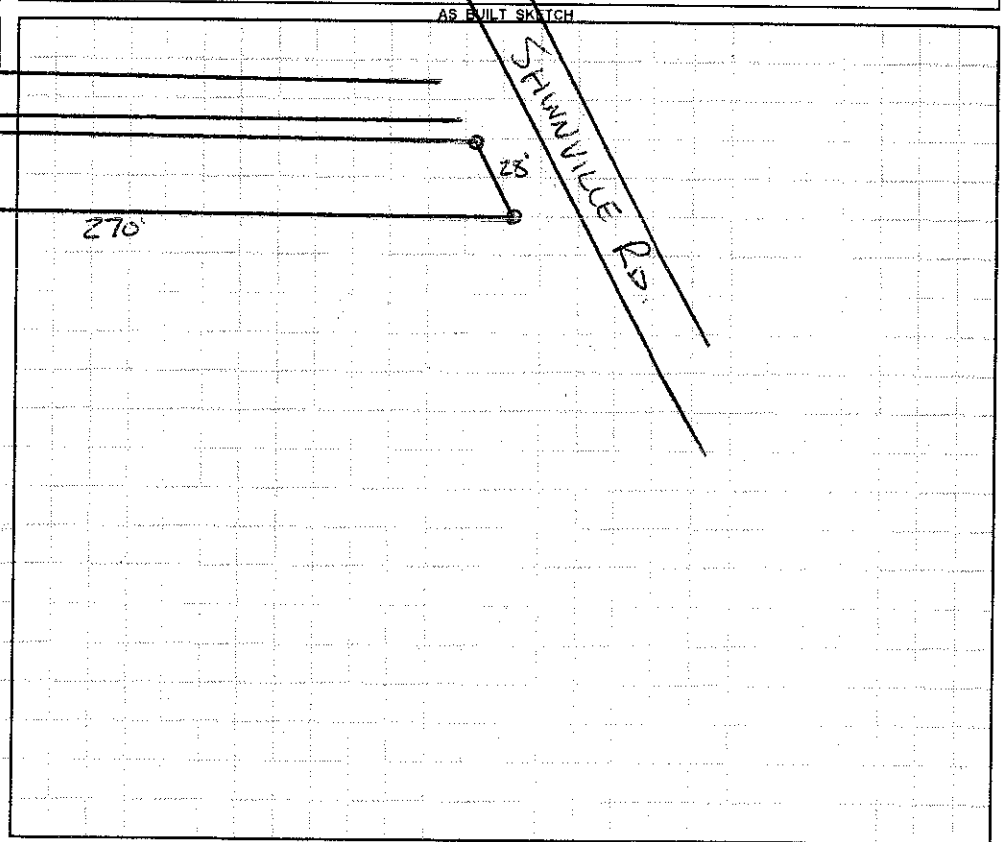

Permit can be suspended or revoked if any false information is supplied toward securing the permit / any unauthorized changes are made to the site / any unauthorized changes are made in the installation of the system. **CONTACT A LOCATOR SERVICE PRIOR TO ANY EXCAVATION**

☐ **IMPROVEMENT PERMIT** *with plat valid without expiration.* ☒ **IMPROVEMENT PERMIT** *with site plan valid for 60 mos.* ☒ **AUTHORIZATION TO CONSTRUCT** *valid for period equal to IMPROVEMENT PERMIT--not to exceed 60 mo.*

Owner / Applicant Signature: Date: 1-30-13 Installed by: Tommy Fox

IMPROVEMENT PERMIT by: Date: 1-29-13 OPERATION PERMIT by: Date: 2-5-13

AUTHORIZATION TO CONSTRUCT by: Date: 1-29-13 Existing System Inspected by: Date:

Health Dept. Copy - WHITE Applicant (Final Approval) - YELLOW Applicant (Conditional Approval) - PINK