Existing System

IREDELL COUNTY HEALTH DEPARTMENT

STATESVILLE 704-878-5305 MOORESVILLE 704-664-5281

IMPROVEMENT PERMIT / AUTHORIZATION TO CONSTRUCT / OPERATION PERMIT / EXISTING SYSTEM INSPECTION

PERMIT# 14255 PIN# 4760987134.000 DATE 10/25/07

OWNER OR APPLICANT Mark Williams PHONE: Business _____ Home 704 528-1853

ADDRESS 127 Apache Trail ~~Mooresville~~ Cleveland NC 27013

LOCATION _____

SUBDIVISION _____ BLOCK / SECTION _____ LOT _____ LOT AREA .9129ac SITE CLASS. _____ DESIGN FLOW 360 L.T.A.R. Exis. .4

Septic Tank: Exis 1000 Gallons; STB _____ Date _____

Pump Tank: _____ Gallons; PT _____ Date _____

Pump Make: _____ Model _____ Serial No. _____

Nitrification Field: No Fields 1 Square Feet 900' Linear Feet 300' Exis

No Lines Ex. 3 Trench Width 36" Max Trench Bottom Depth Exis Gravel Depth 12"

☐ New System ☐ Repair ☐ Expansion System Type: (I) II III IV V VI

System Description: Existing System

Repair System Description: _____

Maintenance Agreement Required: ☐ Yes ☐ No

☐ House/Mod. Home ☑ Mobile Home ☐ Business ☐ Other _____

No. Bedrooms 3 No. Persons _____ No. Employees _____


Water Supply: ☑ Individual ☐ Public ☐ Community

☑ Gravity ☐ Pressure ☐ Slab ☑ Crawl Space ☐ Basement w/plumbing ☐ Basement wo/plumbing


Comments:/Conditions:

Comments:/Conditions: * Place home min 5' from existing drainlines. No visible malfunction observed. Exis system OK. See original permit 8-11-87 Dennis Isenhour Lot 3

INITIAL SITE SKETCH

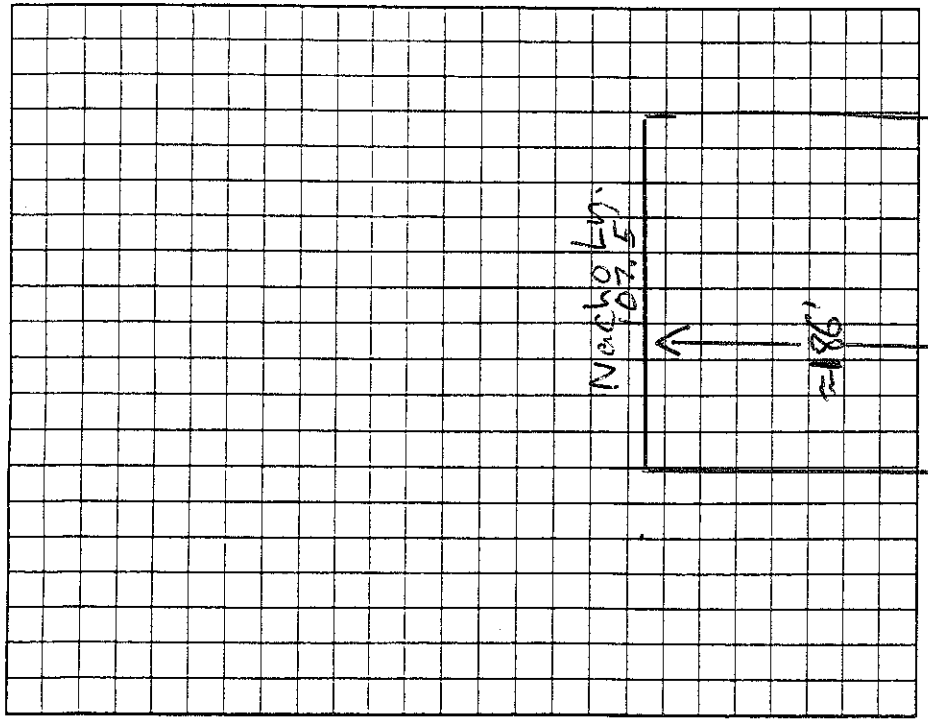

AS BUILT SKETCH

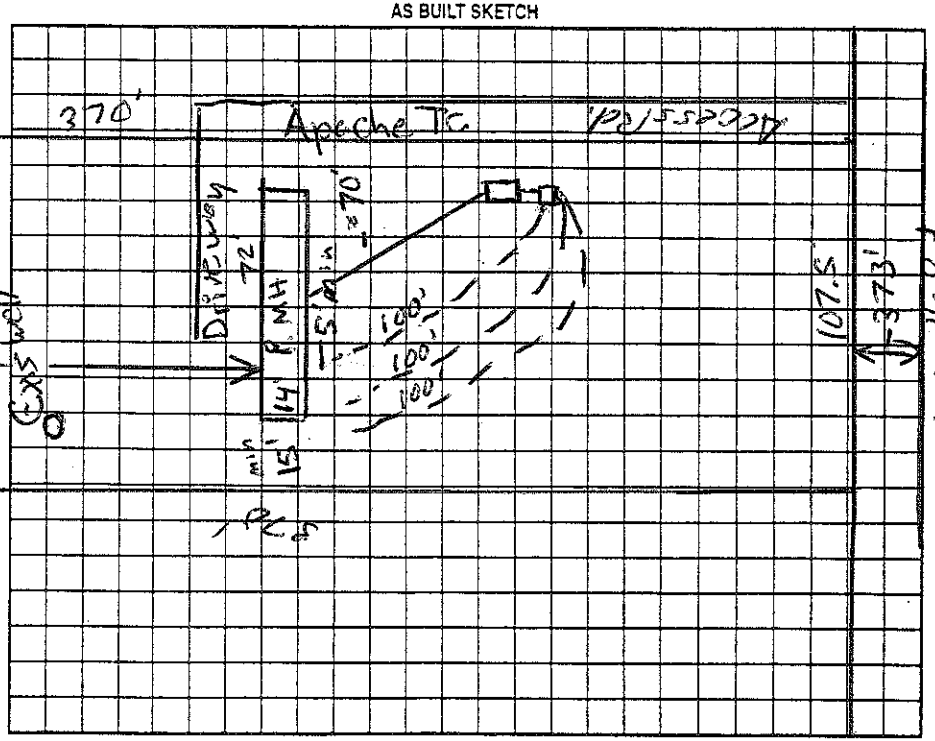

Permit can be suspended or revoked if any false information is supplied toward securing the permit/any unauthorized changes are made to the site/any unauthorized changes are made in the installation of the system. Improvement Permit with plat valid without expiration ☐ Improvement Permit with site plan valid for sixty months ☐ Authorization to Construct is valid for a period equal to that of Improvement Permit – not to exceed sixty months.

Signed: Mark Williams date 10/26/07 Installed by: _____

Improvement Permit by: _____ date _____ Operation Permit by: Anthony Cokes Jr. date 10/25/07

Authorization to Construct by: _____ date _____ Existing System Inspection by: Anthony Cokes Jr. date 10/25/07

HEALTH DEPT. COPY: WHITE OWNER COPY (FINAL): YELLOW OWNER COPY (INITIAL): PINK