11:00

IREDELL COUNTY HEALTH DEPARTMENT

STATESVILLE 704-878-5305 MOORESVILLE 704-664-5281

IMPROVEMENT PERMIT / AUTHORIZATION TO CONSTRUCT / OPERATION PERMIT / EXISTING SYSTEM INSPECTION

PERMIT# 14229 PIN# 4761020383 DATE 5-23-07

OWNER OR APPLICANT TAF Design PHONE: Business 704-201-3546 Home

ADDRESS PO Box 5474 Mooresville NC 28117

LOCATION Hwy 21 N (R) Oswalt Amity (R) Weathers Creek (R) Tree Top lot on Right

SUBDIVISION OAK RIDGE BLOCK / SECTION LOT 16 LOT AREA SITE CLASS. PS DESIGN FLOW 360 L.T.A.R. .30

Septic Tank: 1000 Gallons; STB 994 Date 5-13-07

Pump Tank: Gallons; PT Date

Pump Make: Model Serial No.

Nitrification Field: No Fields 1 Square Feet 900 Linear Feet 300'

No Lines 3@100' Trench Width 36" Max Trench Bottom Depth 36" Gravel Depth — ☒ Gravity ☐ Pressure

☐ New System ☐ Repair ☐ Expansion System Type: I II III IV V VI

System Description: 25% Reduction

Repair System Description: SAME

Maintenance Agreement Required: ☐ Yes ☒ No

☒ House/Mod. Home No. Bedrooms 3

☐ Mobile Home No. Persons

☐ Business No. Employees

☐ Other


Water Supply: ☒ Individual ☐ Public ☐ Community

☐ Slab ☒ Crawl Space ☐ Basement w/plumbing ☐ Basement wo/plumbing

Comments:/Conditions:


PL = 314

INITIAL SITE SKETCH

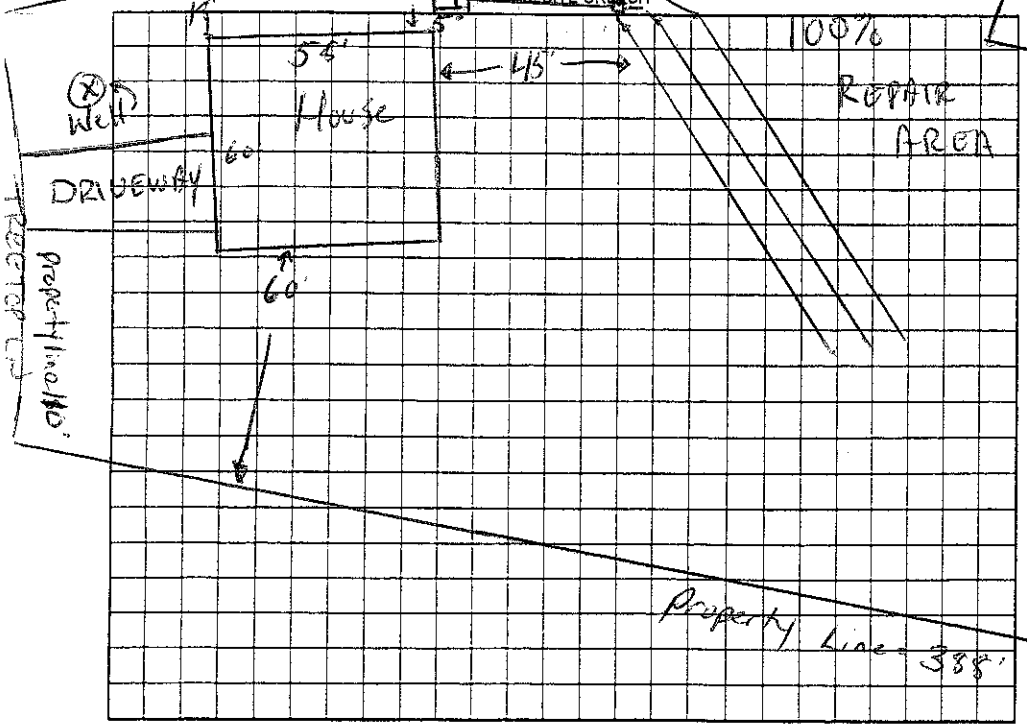

Comments:/Conditions:

AS BUILT SKETCH

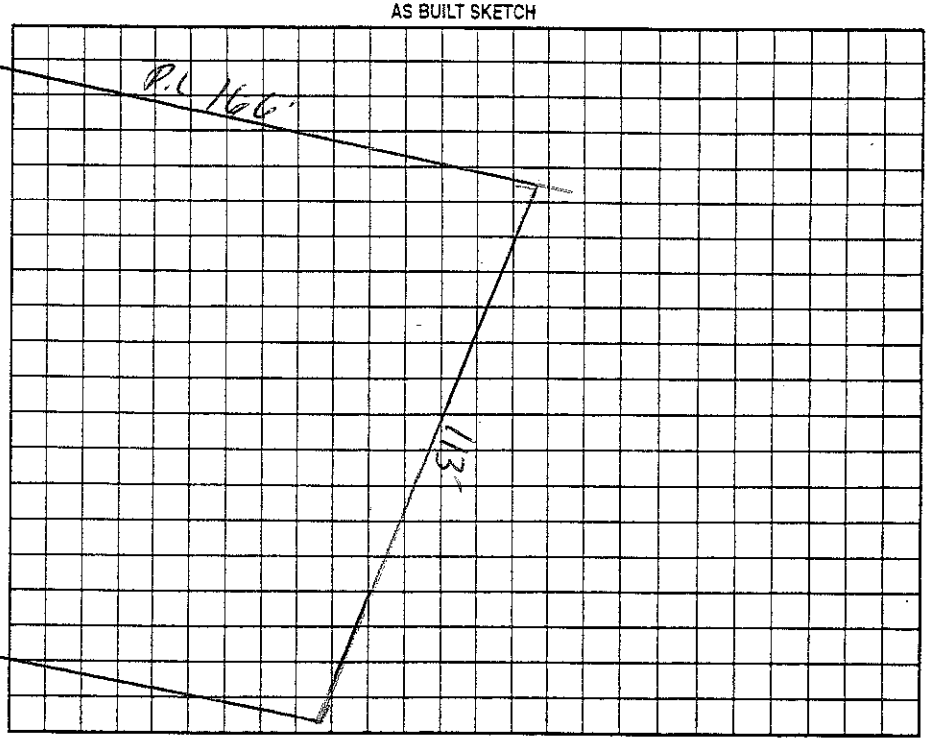

Permit can be suspended or revoked if any false information is supplied toward securing the permit/any unauthorized changes are made to the site/any unauthorized changes are made in the installation of the system. Improvement Permit with plat valid without expiration. ☐ Improvement Permit with site plan valid for sixty months ☒ Authorization to Construct is valid for a period equal to that of Improvement Permit – not to exceed sixty months.

Signed: date 5-24-07 Installed by: Chris Rosevelt

Improvement Permit by: date 5-23-07 Operation Permit by: date 6-22-07

Authorization to Construct by: date 5-23-07 Existing System Inspection by: date

HEALTH DEPT. COPY: WHITE OWNER COPY (FINAL): YELLOW OWNER COPY (INITIAL): PINK