IREDELL COUNTY HEALTH DEPARTMENT

STATESVILLE 704-878-5305 MOORESVILLE 704-664-5281

225.00 Paid

IMPROVEMENT PERMIT / AUTHORIZATION TO CONSTRUCT / OPERATION PERMIT / EXISTING SYSTEM INSPECTION

PERMIT# 138111 PIN# 4761024005 DATE 1-5-07

OWNER OR APPLICANT Corinthian Builders PHONE: Business 400-1258 Home

ADDRESS PO. Box 990 Denver, NC 28037

LOCATION Oswalt Amity TR Weathers Creek TR Treetop on left

SUBDIVISION Oak Ridge BLOCK SECTION LOT 11 LOT AREA .77Acre SITE CLASS. DS DESIGN FLOW 360gpd L.T.A.R. .25

Septic Tank: 1000 Gallons; STB 7183 Date 2/15/07

Pump Tank: 1000 Gallons; PT 32 Date 11/10/06

Pump Make: Cowans Model WEO-3HM Serial No.

Nitrification Field: No Fields 1 Square Feet 780' Linear Feet 260'

No Lines 5 Trench Width 36" Max Trench Bottom Depth 36" Gravel Depth N/A

☒ New System ☐ Repair ☐ Expansion System Type: I II III IV V VI

System Description: Pump-LP- Panel Block

Repair System Description: Same

Maintenance Agreement Required: ☒ Yes ☐ No

☒ House/Mod. Home No. Bedrooms 3

☐ Mobile Home No. Persons

☐ Business No. Employees

☐ Other


Water Supply: ☒ Individual ☐ Public ☐ Community

☐ Gravity ☒ Pressure ☐ Slab ☐ Crawl Space ☐ Basement w/plumbing ☐ Basement wo/plumbing


Comments:/Conditions: Scale 1:40

Comments:/Conditions: Note: Only 240ft of Drainfield required @ .25 LTAR. Approved plan submitted by Rollans Soil & Environmental Services

INITIAL SITE SKETCH

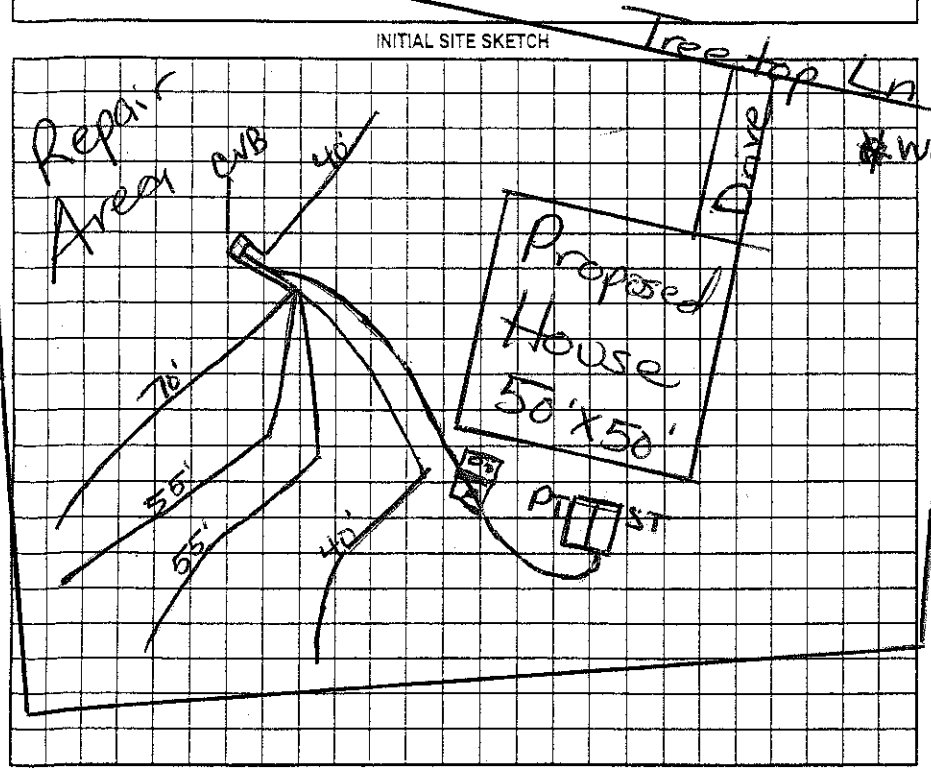

AS BUILT SKETCH

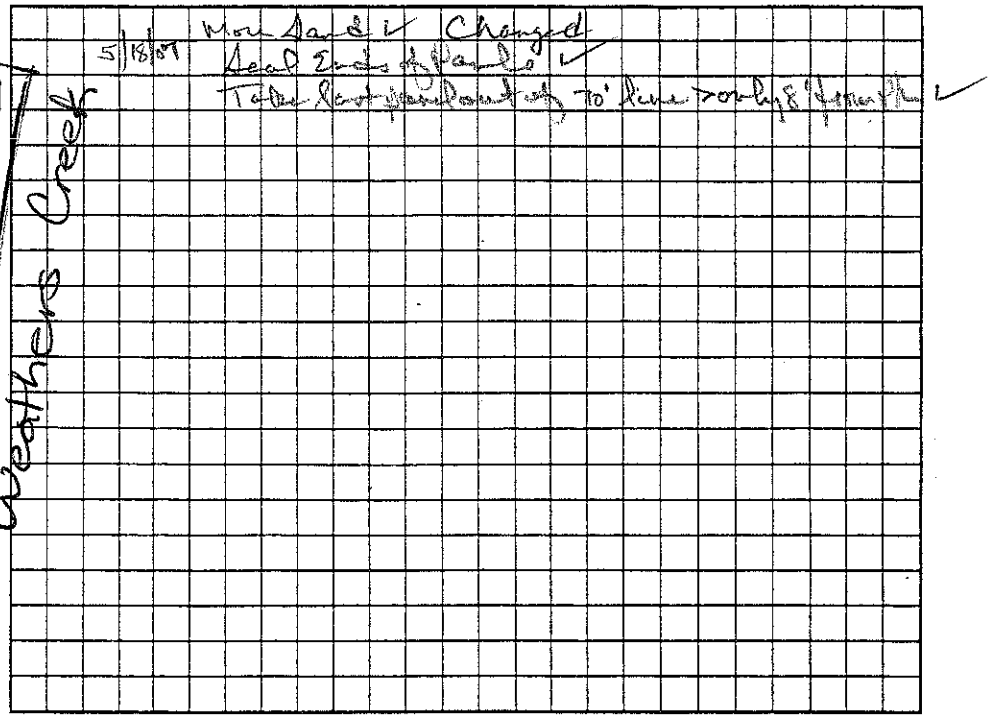

Permit can be suspended or revoked if any false information is supplied toward securing the permit/any unauthorized changes are made to the site/any unauthorized changes are made in the installation of the system. Improvement Permit with plat valid without expiration ☐ Improvement Permit with site plan valid for sixty months ☐ Authorization to Construct is valid for a period equal to that of Improvement Permit – not to exceed sixty months.

Signed: Aurora Deon - agent 02/2/07 Installed by: Corinthian Dev.

Improvement Permit by: Maija Hill Dotson RS date 1/5/07 Operation Permit by: Wesley Sparks R.S. date 5/31/07

Authorization to Construct by: Wesley Sparks RS date 2/14/07 Existing System Inspection by: date

HEALTH DEPT. COPY: WHITE OWNER COPY (FINAL): YELLOW OWNER COPY (INITIAL): PINK