IREDELL COUNTY HEALTH DEPARTMENT

STATESVILLE 704-878-5305 MOORESVILLE 704-664-5281

IMPROVEMENT PERMIT / AUTHORIZATION TO CONSTRUCT / OPERATION PERMIT / EXISTING SYSTEM INSPECTION

PERMIT# 13885 1 PIN# 4761024243

OWNER OR APPLICANT Corinthian Builders PHONE: Business 400-1258 Home

ADDRESS P.O. Box 990 Denver NC. 28037 DATE 1-8-07

LOCATION Oswalt Amity Rd TR Weathers Creek Rd TR Treetop Ln on right

SUBDIVISION Oak Ridge BLOCK / SECTION LOT 12 LOT AREA .678 SITE CLASS PS DESIGN FLOW 360 L.T.A.R. .25

Septic Tank: 1000 Gallons: STB 165 Date 2-28-07

Pump Tank: 1000 Gallons: PT 44 Date 3-11-07

Pump Make: Bowlus Model LWE-3111M Serial No.

Nitrification Field: No Fields 1 Square Feet 1080 Linear Feet 360'

No Lines 3@120' Trench Width 36" Max Trench Bottom Depth 36"

Gravel Depth N/A

☒ New System ☐ Repair ☐ Expansion System Type: I II III IV V VI

System Description: Pump - PM - 25% Red

Repair System Description: PP - Panel Block

Maintenance Agreement Required: ☐ Yes ☒ No Not Initially

☐ Gravity ☒ Pressure ☐ Slab ☒ Crawl Space ☐ Basement w/plumbing ☐ Basement wo/plumbing

☒ House/Mod. Home ☐ Mobile Home ☐ Business ☐ Other


No. Bedrooms 3 No. Persons No. Employees

Water Supply: ☒ Individual ☐ Public ☐ Community

Comments:/Conditions: Approved plan submitted by Rollans Environmental Services

Comments:/Conditions: 2/23/07 Reviewed floor plans in compliance with original permit/plan Must place house as shown

INITIAL SITE SKETCH

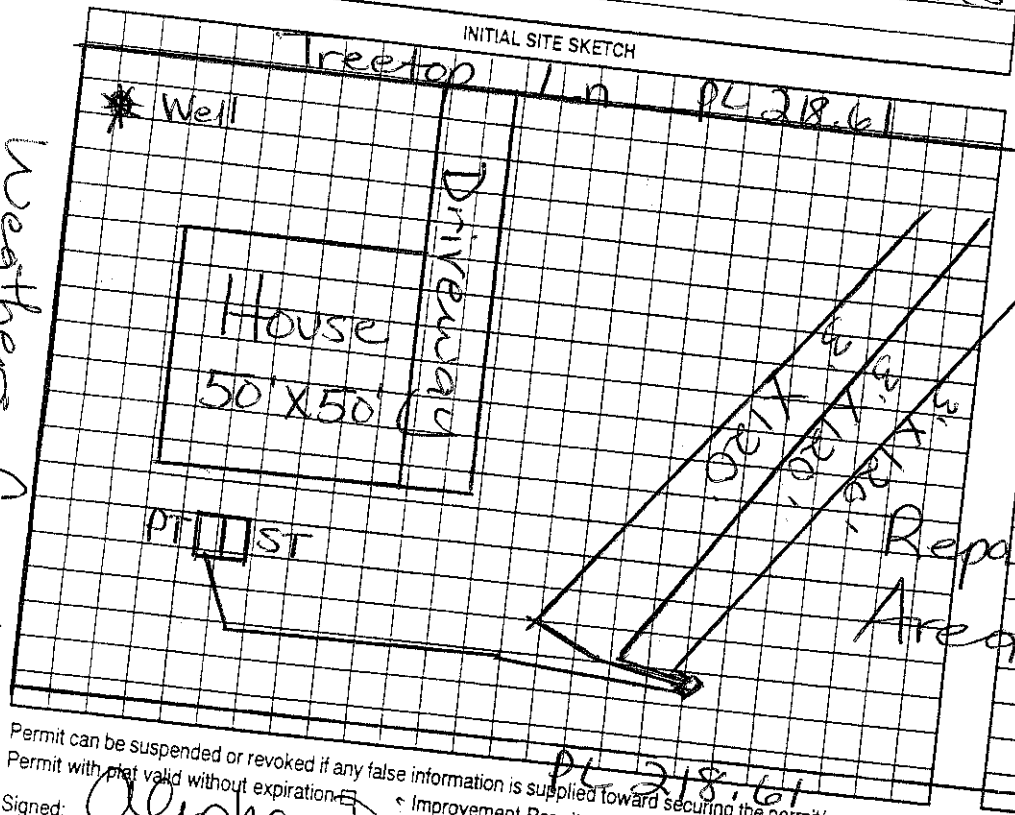

AS BUILT SKETCH



Weathers Creek Rd

Permit can be suspended or revoked if any false information is supplied toward securing the permit/any unauthorized changes are made to the site/any unauthorized changes are made in the installation of the system. Improvement Permit with plat valid without expiration ☐ Improvement Permit with site plan valid for sixty months ☐ Authorization to Construct is valid for a period equal to that of Improvement Permit – not to exceed sixty months.

Signed: Alisha Dean - agent

Improvement Permit by: Marion H. Dalton RS date 2/20/07

Authorization to Construct by: Marion H. Dalton RS date 1/8/07

Installed by: Corinthian Builders

Operation Permit by: Wesley Parker RS. date 2/23/07

Existing System Inspection by: date 5/31/07

HEALTH DEPT. COPY: WHITE OWNER COPY (FINAL): YELLOW OWNER COPY (INITIAL): PINK