IREDELL COUNTY HEALTH DEPARTMENT

STATESVILLE 704-878-5305 MOORESVILLE 704-664-5281

IMPROVEMENT PERMIT / AUTHORIZATION TO CONSTRUCT / OPERATION PERMIT / EXISTING SYSTEM INSPECTION

PERMIT# 13885 PIN# 4761024243 DATE 1-8-07

OWNER OR APPLICANT Corinthian Builders PHONE: Business 400-1258 Home

ADDRESS P.O. Box 990 Denver NC 28037

LOCATION Oswalt Amity Rd TR Weathers Creek Rd TR Treetop Ln on right

SUBDIVISION Oak Ridge BLOCK / SECTION LOT 12 LOT AREA .678 SITE CLASS. PS DESIGN FLOW 360 L.T.A.R. .25

Septic Tank: 1000 Gallons; STB 165 Date 2-28-07
Pump Tank: 1000 Gallons; PT 44 Date 3-11-07
Pump Make: Bowlds Model LWE-3HHA Serial No.
Nitrification Field: No Fields 1 Square Feet 1080 Linear Feet 360'
No Lines 3@120' Trench Width 36" Max Trench Bottom Depth 36"

☒ New System ☐ Repair ☐ Expansion System Type: I II III IV V VI
System Description: Pump - PM - 25/10 Red
Repair System Description: LP - Panel Block
Maintenance Agreement Required: ☐ Yes ☒ No Not Initially

☒ House/Mod. Home No. Bedrooms 3
☐ Mobile Home No. Persons
☐ Business No. Employees
☐ Other


Water Supply: ☒ Individual ☐ Public ☐ Community

Gravel Depth N/A ☐ Gravity ☒ Pressure ☐ Slab ☒ Crawl Space ☐ Basement w/plumbing ☐ Basement wo/plumbing


Comments/Conditions: Approved plan submitted by Rollins Environmental Services

Comments/Conditions: 2/23/07 Reviewed Floor plans, in Compliance with original permit/plan Must place house as shown

INITIAL SITE SKETCH

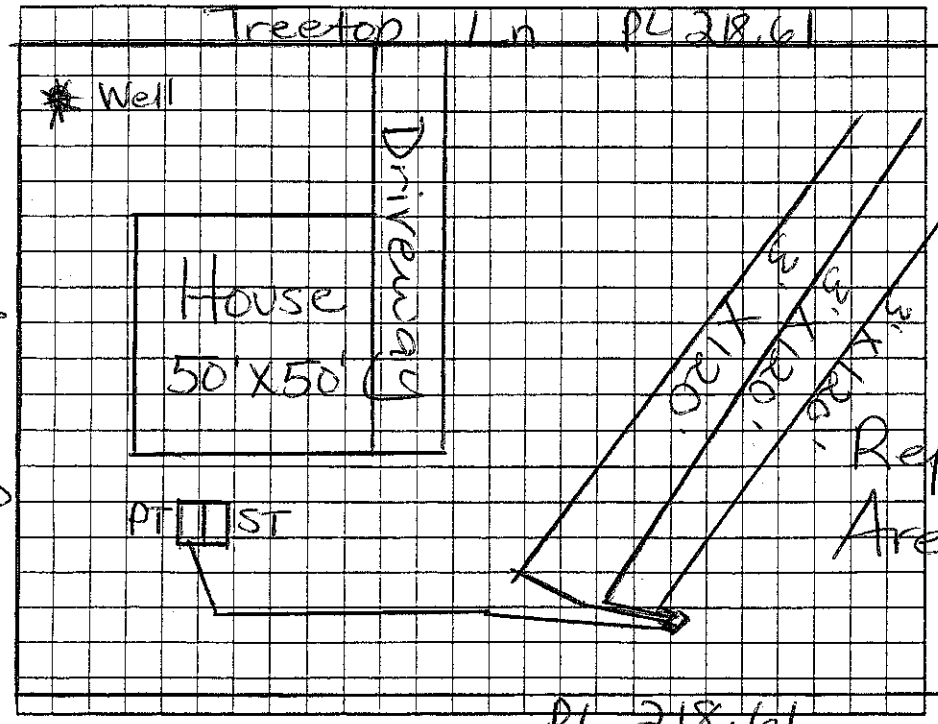

AS BUILT SKETCH

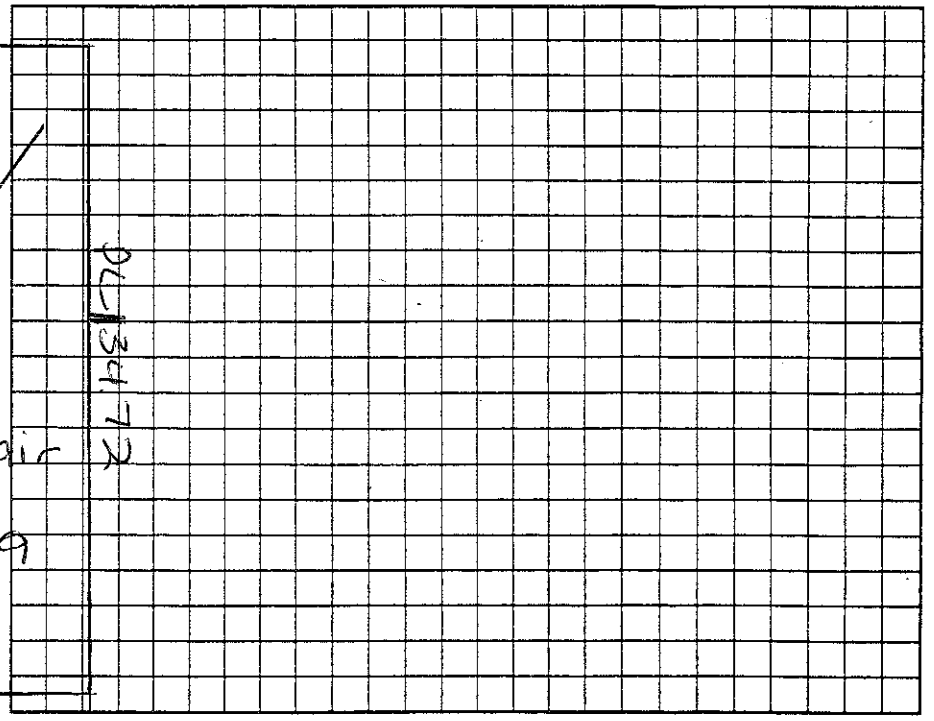

Weathers Creek

Permit can be suspended or revoked if any false information is supplied toward securing the permit/any unauthorized changes are made to the site/any unauthorized changes are made in the installation of the system. Improvement Permit with plat valid without expiration ☐ Improvement Permit with site plan valid for sixty months ☐ Authorization to Construct is valid for a period equal to that of Improvement Permit – not to exceed sixty months.

Signed: Alisha Dean-agent date 2/20/07 Installed by: Corinthian Builders

Improvement Permit by: Marion H. Dalton RS date 1/8/07 Operation Permit by: Wesley Parks RS. date 5/31/07

Authorization to Construct by: Marion H. Dalton RS date 2/23/07 Existing System Inspection by: date

HEALTH DEPT. COPY: WHITE OWNER COPY (FINAL): YELLOW OWNER COPY (INITIAL): PINK