IREDELL COUNTY HEALTH DEPARTMENT

STATESVILLE 704-878-5305 MOORESVILLE 704-664-5261

IMPROVEMENT PERMIT / AUTHORIZATION TO CONSTRUCT / OPERATION PERMIT / EXISTING SYSTEM INSPECTION

PERMIT# 138855 PIN# 4761024349

OWNER OR APPLICANT Carpathian Builders

ADDRESS P.O. Box 790 Denver NC 28037 PHONE: Business 400-1258 Home

LOCATION Dstwalt Amity Rd TR Weathers Creek on right before Treetop Ln DATE 1-8-07

SUBDIVISION Oak Ridge BLOCK/SECTION LOT 13 LOT AREA 1.683 Acre SITE CLASS. PS DESIGN FLOW 360gpd T.A.R. .275

Septic Tank: 1000 Gallons: STB 750 Date 3/16/07

Pump Tank: 1000 Gallons: PT 32 Date 3/17/07

Pump Make: Cowans Model Regina Serial No.

Nitrification Field: No Fields 1 Square Feet 981 Linear Feet 327

No Lines 3 @ 109' Trench Width 36" Max Trench Bottom Depth 30

☒ New System ☐ Repair ☐ Expansion System Type: I II ☒ III IV V VI

System Description: Pump - 25% Reduction

Repair System Description: LP - Panel Block

Maintenance Agreement Required: ☐ Yes ☒ No Not Initially

Gravel Depth N/A ☐ Gravity ☒ Pressure ☐ Slab ☒ Crawl Space ☐ Basement w/plumbing ☐ Basement wo/plumbing

☒ House/Mod. Home ☐ Mobile Home ☐ Business ☐ Other


No. Bedrooms 3 No. Persons ___ No. Employees ___

Water Supply: ☒ Individual ☐ Public ☐ Community


Comments:/Conditions: Approved plan submitted by Rollans Soils Environmental Services.

Comments:/Conditions: 2/23/07 Reviewed Floor plans. in Compliance with original permit/plan Place house as shown on plan/plan

Scale 1:40 INITIAL SITE SKETCH

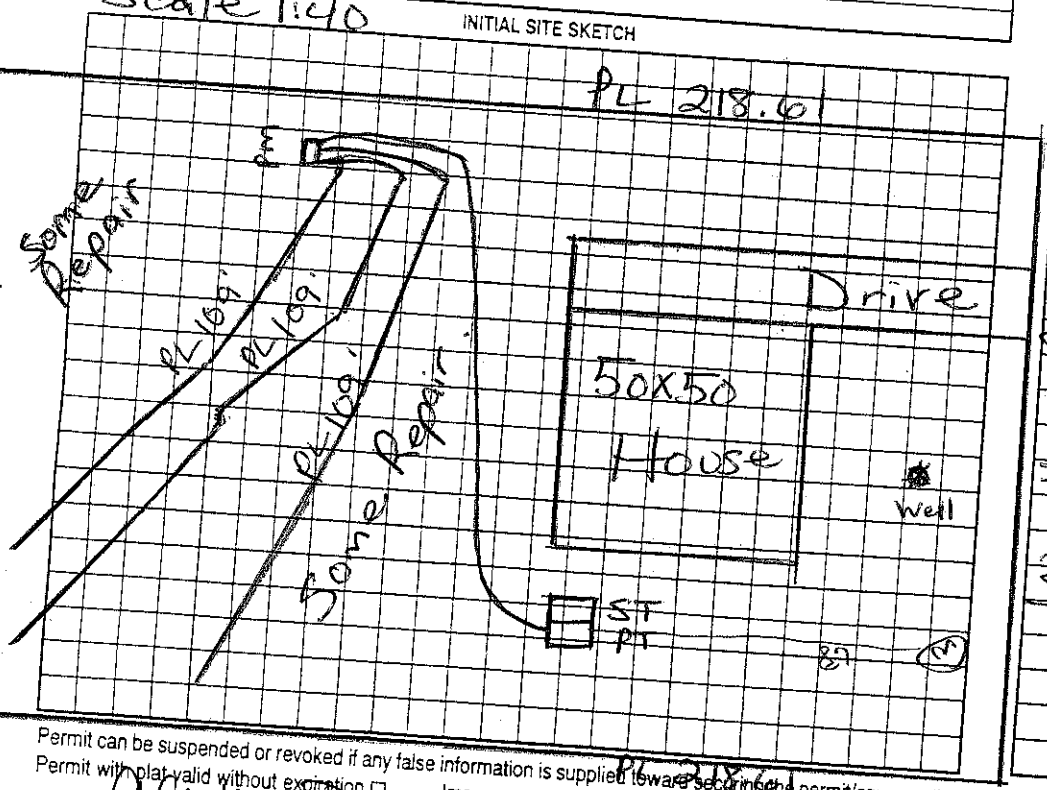

AS BUILT SKETCH

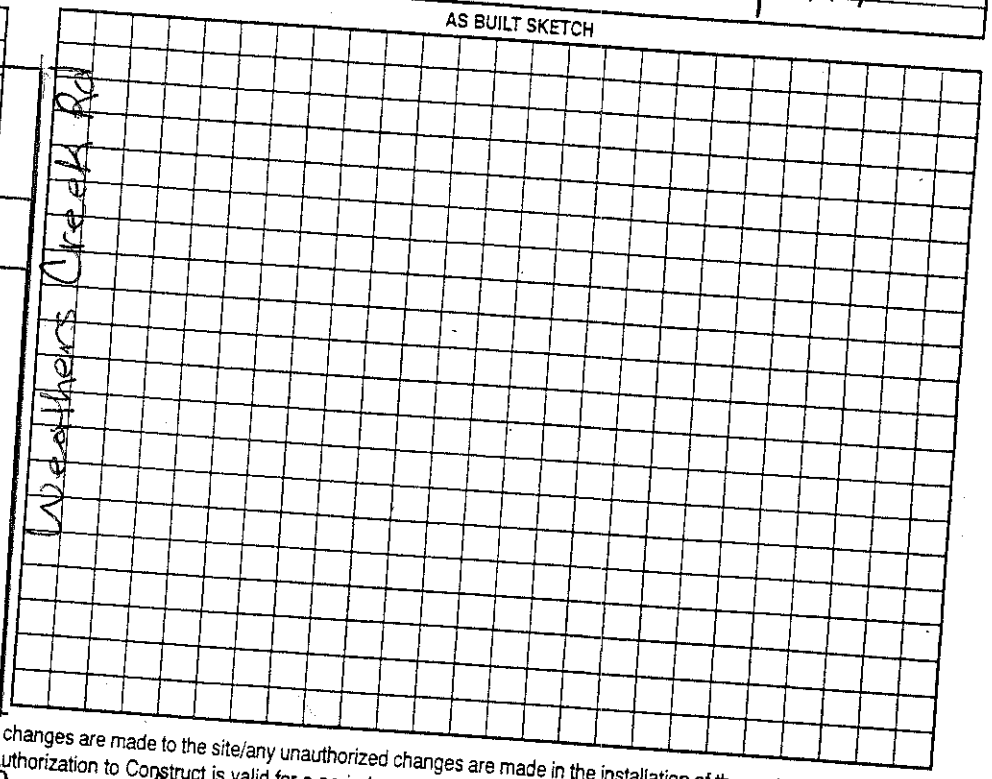

Permit can be suspended or revoked if any false information is supplied toward securing the permit/any unauthorized changes are made to the site/any unauthorized changes are made in the installation of the system. Improvement Permit with plat valid without expiration ☐ Improvement Permit with site plan valid for sixty months ☐ Authorization to Construct is valid for a period equal to that of Improvement Permit – not to exceed sixty months.

Signed: Alisha Dixon - agent

Improvement Permit by: [signature] RS date 2/20/07

Authorization to Construct by: [signature] RS date 1/8/07

Installed by: Carpathian Builders

Operation Permit by: Wally Perkins date 8/20/07

Existing System Inspection by: [signature] RS date 2/23/07

HEALTH DEPT. COPY: WHITE OWNER COPY (FINAL): YELLOW OWNER COPY (INITIAL): PINK