IREDELL COUNTY HEALTH DEPARTMENT

STATESVILLE 704-878-5305 MOORESVILLE 704-664-5281

IMPROVEMENT PERMIT / AUTHORIZATION TO CONSTRUCT / OPERATION PERMIT / EXISTING SYSTEM INSPECTION

PERMIT# 138855 PIN# 4761024349 DATE 1-8-07

OWNER OR APPLICANT Corinthian Builders PHONE: Business 400-1258 Home

ADDRESS P.O. Box 990 Denver NC 28037

LOCATION Dstwat Amity Rd TR Weathers Creek on right before Treetop Ln

SUBDIVISION Oak Ridge BLOCK/SECTION LOT 13 LOT AREA .683 Acre SITE CLASS. PS DESIGN FLOW 360gpd L.T.A.R. .275

Septic Tank: 1000 Gallons: STB 32 Date 3/1/07

Pump Tank: 1000 Gallons: PT 32 Date 3/1/07

Pump Make: Cowans Model DESIGN Serial No.

Nitrification Field: No Fields 1 Square Feet 981 Linear Feet 327

No Lines 3@109' Trench Width 36" Max Trench Bottom Depth 30"

☒ New System ☐ Repair ☐ Expansion System Type: I II III IV V VI

System Description: Pump - 250g Reduction

Repair System Description: LP - Panel Block

Maintenance Agreement Required: ☐ Yes ☒ No Not Initially

☒ House/Mod. Home No. Bedrooms 3

☐ Mobile Home No. Persons

☐ Business No. Employees

☐ Other


Water Supply: ☒ Individual ☐ Public ☐ Community

Gravel Depth N/A ☐ Gravity ☒ Pressure ☐ Slab ☒ Crawl Space ☐ Basement w/plumbing ☐ Basement wo/plumbing


Comments/Conditions: Approved plan submitted by Rollans Soil & Environmental Services.

Comments/Conditions: 2/23/07 Reviewed Floor plans, in Compliance with Original permit/plan Place house as shown on plan.

Scale 1:40 INITIAL SITE SKETCH

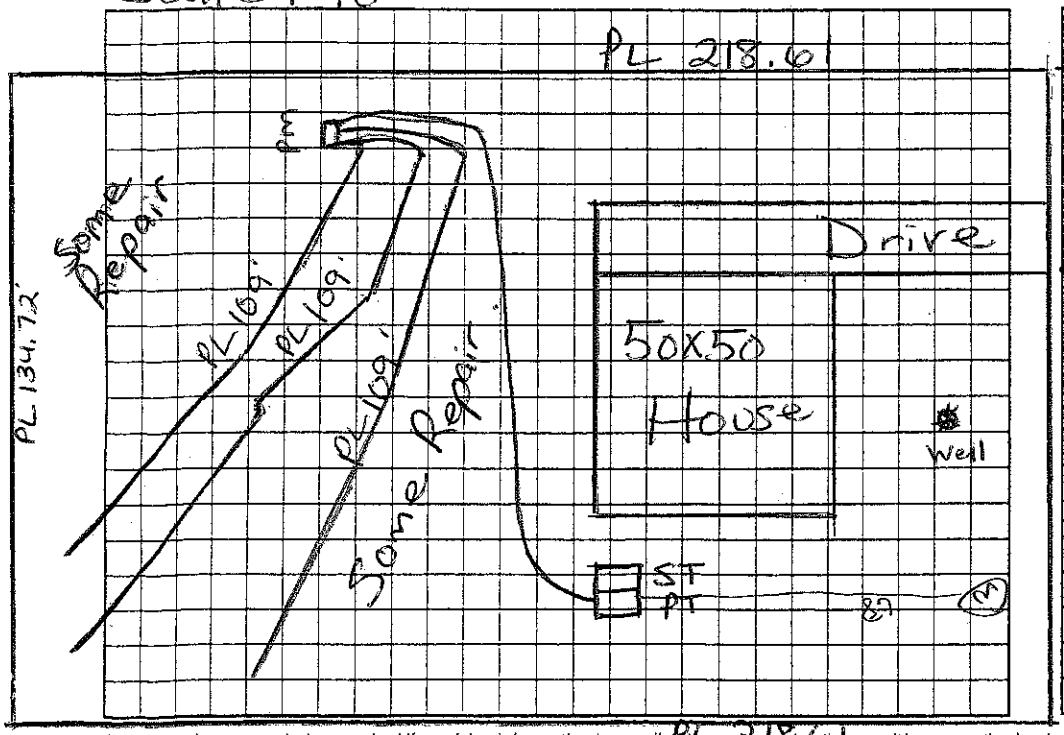

AS BUILT SKETCH

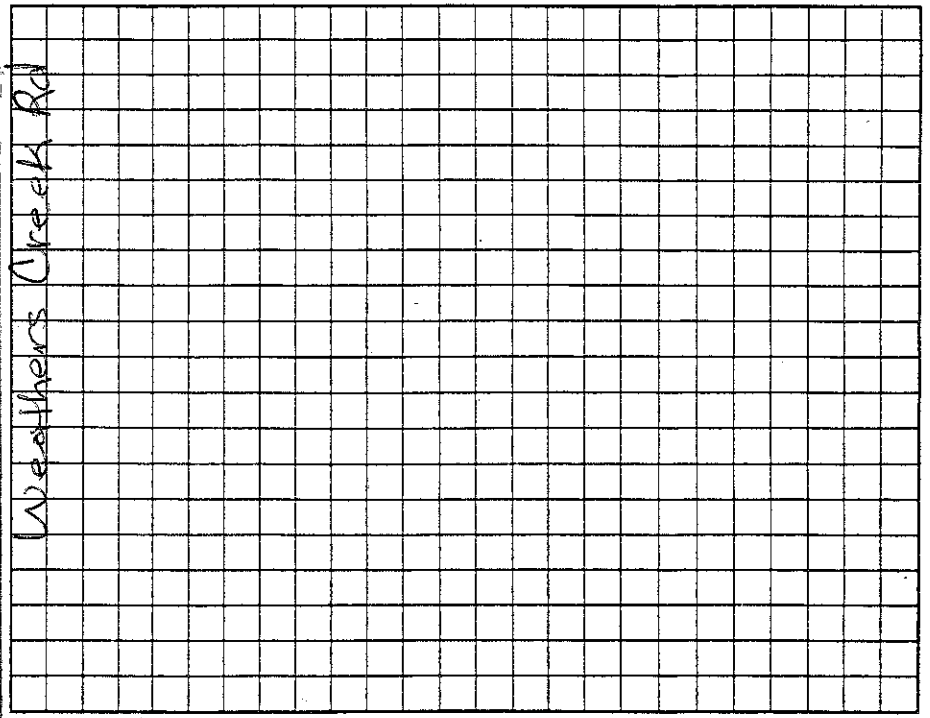

Permit can be suspended or revoked if any false information is supplied toward securing the permit/any unauthorized changes are made to the site/any unauthorized changes are made in the installation of the system. Improvement Permit with plat valid without expiration ☐ Improvement Permit with site plan valid for sixty months ☐ Authorization to Construct is valid for a period equal to that of Improvement Permit – not to exceed sixty months.

Signed: Alisha Dixon - agent date 2/20/07

Improvement Permit by: Marvin Hilton RS date 1/8/07

Authorization to Construct by: Marvin Hilton RS date 2/23/07

Installed by: Corinthian Builders

Operation Permit by: Wesley Perkins date 8/20/07

Existing System Inspection by: date

HEALTH DEPT. COPY: WHITE OWNER COPY (FINAL): YELLOW OWNER COPY (INITIAL): PINK