# L COUNTY HEALTH DEPARTMENT

STATESVILLE 704-878-5305 MOORESVILLE 704-664-5281

## EMENT PERMIT / AUTHORIZATION TO CONSTRUCT / OPERATION PERMIT / EXISTING SYSTEM INSPECTION

6991 PIN# 4761-02-7644

OR APPLICANT AMERICA'S HOME PLACE DATE 08/02/06

ADDRESS 168-D NORMAN STATION BLVD. MOORESVILLE, NC 28117 PHONE: Business 704-746-7094 Home 704-664-5800

LOCATION HWY 21 NORTH, (R) OSWALT AMITY RD., (R) WEATHERS CREEK RD. [redacted] ON LEFT.

SUBDIVISION OAK RIDGE BLOCK / SECTION 1 LOT 4 LOT AREA 0.966 Ac. SITE CLASS. PS DESIGN FLOW 480 GPD L.T.A.R. 0.25 GPD/FT²

Septic Tank: 1,000 Gallons; STB 1007 Date 8-18-06

Pump Tank: Gallons; PT Date

Pump Make: Model Serial No.

Nitrification Field: No Fields 1 Square Feet EQ to 1920 Linear Feet 480'

No Lines 5@100' Trench Width 36" Max Trench Bottom Depth 36" Gravel Depth N/A

☒ New System ☐ Repair ☐ Expansion System Type: I II III IV V VI

System Description: 25% REDUCTION, GRAVITY

Repair System Description: 25% REDUC., GRAVITY

Maintenance Agreement Required: ☐ Yes ☒ No

☒ Gravity ☐ Pressure ☐ Slab ☒ Crawl Space ☐ Basement w/plumbing ☐ Basement wo/plumbing

☒ House/Mod. Home ☐ Mobile Home ☐ Business ☐ Other

No. Bedrooms 4 No. Persons No. Employees


Water Supply: ☒ Individual WELL ☐ Public ☐ Community

Comments:/Conditions:


Comments:/Conditions:

Septic tank w/ marker
Filter Bouxo Ind.

INITIAL SITE SKETCH

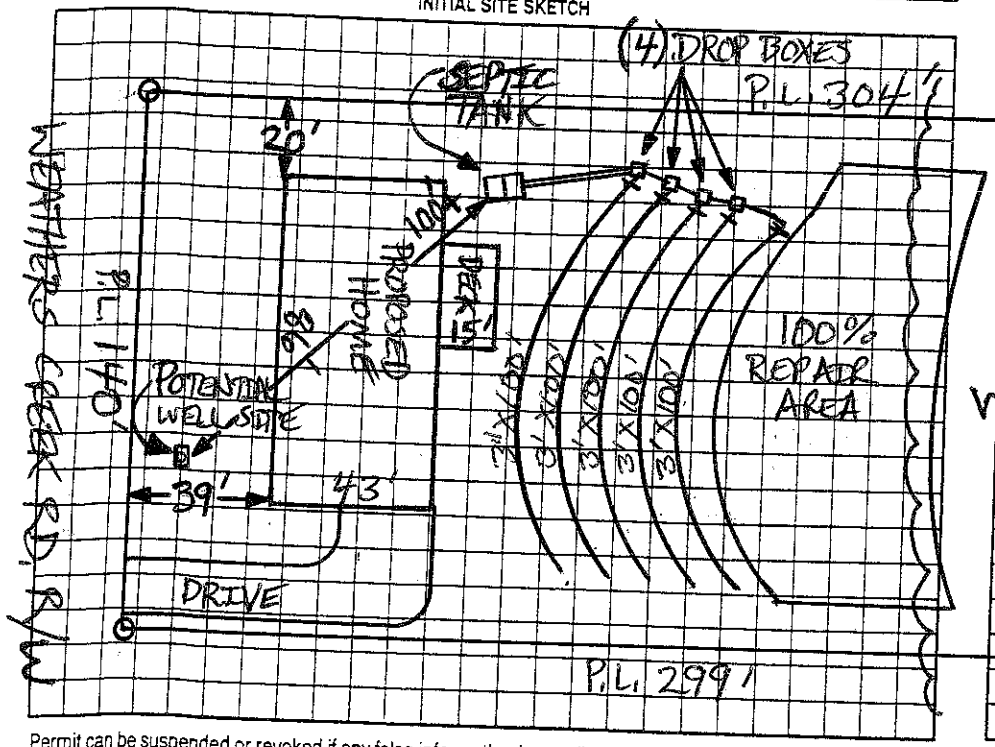


AS BUILT SKETCH

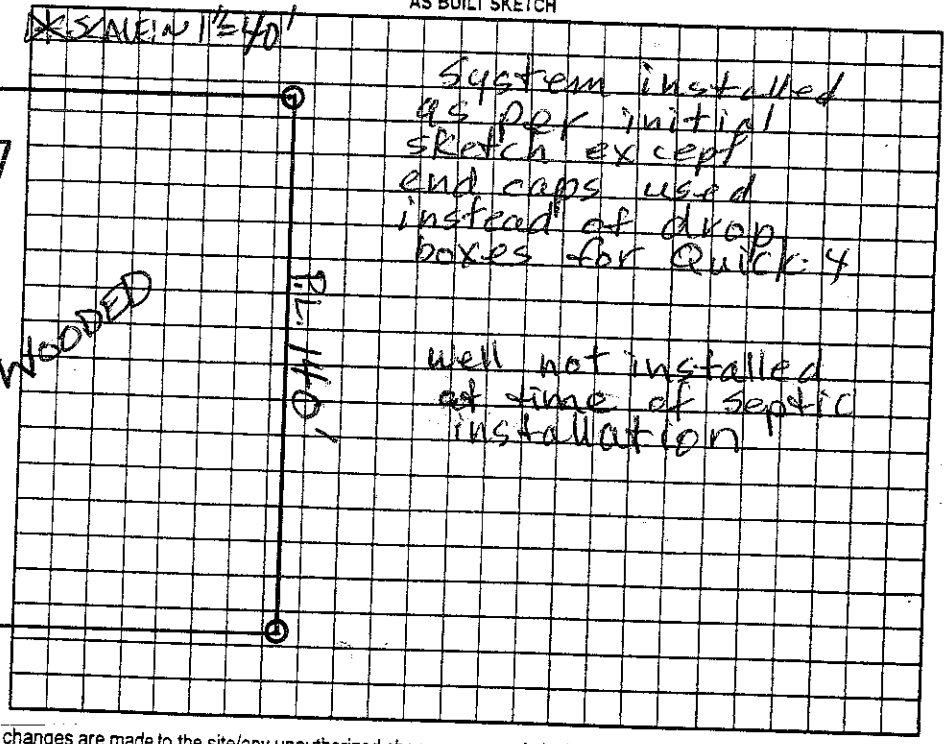


System installed as per initial sketch except end caps used instead of drop boxes for Quick 4

well not installed at time of septic installation

Permit can be suspended or revoked if any false information is supplied toward securing the permit/any unauthorized changes are made to the site/any unauthorized changes are made in the installation of the system. Improvement Permit with plat valid without expiration. ☐ Improvement Permit with site plan valid for sixty months ☒ Authorization to Construct is valid for a period equal to that of Improvement Permit – not to exceed sixty months.

Signed: Chad Hollar date 8/16/06

Improvement Permit by: [signature] date 08/02/06

Authorization to Construct by: [signature] date 08/02/06

Installed by: K+M Grading

Operation Permit by: Cindy Mehaffey date 9-26-06

Existing System Inspection by: date

HEALTH DEPT. COPY: WHITE OWNER COPY (FINAL): YELLOW OWNER COPY (INITIAL): PINK