IREDELL COUNTY HEALTH DEPARTMENT

STATESVILLE 704-878-5305 MOORESVILLE 704-664-5281

IMPROVEMENT PERMIT / AUTHORIZATION TO CONSTRUCT / OPERATION PERMIT / EXISTING SYSTEM INSPECTION

$50 Pd 3.00

PERMIT# 105709 PIN# 4761-02-3867.5 4761-05-3073

OWNER OR CONTRACTOR TCC VANDERBUILT DATE 6/20/03

ADDRESS 844 S. MAIN ST TROUTMAN NC 28166 PHONE: Business 528-3320 Home

LOCATION CSWALT AMCT4 - TR WEATHERS CREEK - TR TRACT - 2nd ON RT

SUBDIVISION RYANWOODS BLOCK / SECTION LOT 5 LOT AREA 1.58 AC SITE CLASS. PS DESIGN FLOW 360 GPD L.T.A.R. . 3600/FT2

Septic Tank: 1000 Gallons; STB 794 Date 8/15/03

Pump Tank: Gallons; PT Date

Pump Make: Model Serial No.

Nitrification Field: No Fields 1 Square Feet 900 Linear Feet 300

No Lines 4@75' Trench Width 36" Max Trench Bottom Depth 24" Gravel Depth N/A

☑ New System ☐ Repair System Type: I, II, III, IV, V, VI

System Description: GRAVITY 25% REDUCTION PANEL

Repair System Description:

Maintenance Agreement Required: ☐ Yes ☑ No

☑ House/Mod. Home No. Bedrooms 3

☐ Mobile Home No. Bathrooms 3

☐ Business No. Employees

☐ Other


☐ Slab ☑ Crawl Space ☐ Basement w/plumbing ☐ Basement wo/plumbing

Water Supply: ☑ Individual ☐ Public ☐ Community

Comments:/Conditions:

Comments:/Conditions:

INITIAL SITE SKETCH 1"=50'

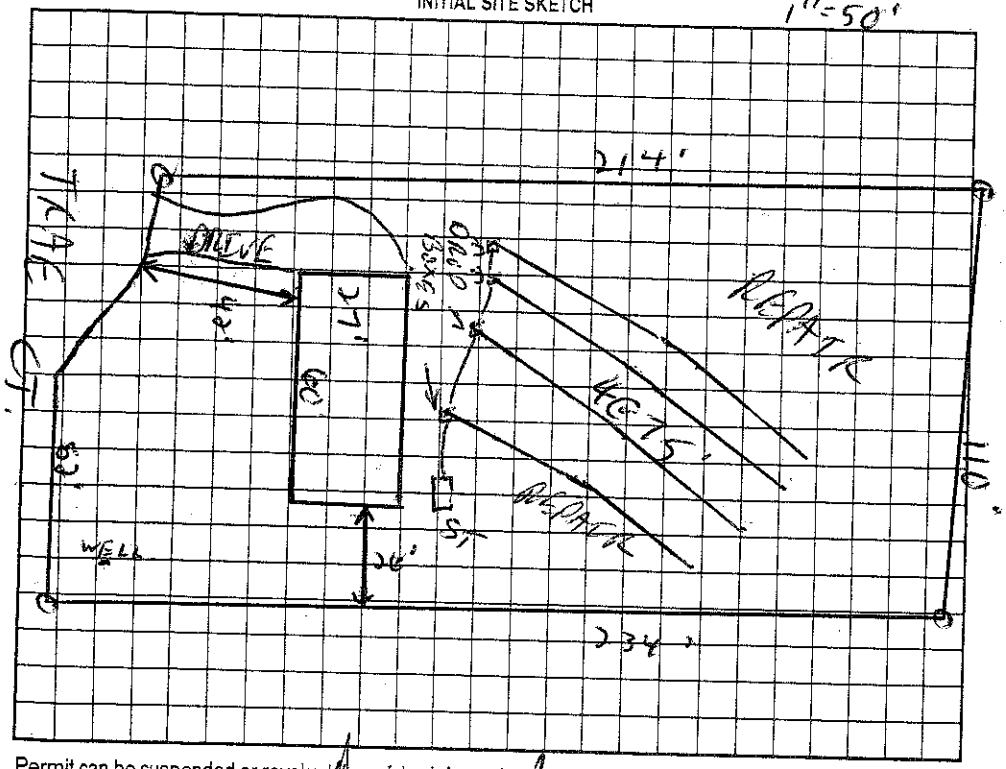

AS BUILT SKETCH

Permit can be suspended or revoked if any false information is supplied toward securing the permit/any unauthorized changes are made to the site/any unauthorized changes are made in the installation of the system. Improvement Permit with plat valid without expiration. Improvement Permit with site plan valid for sixty months. Authorization to Construct is valid for a period equal to that of Improvement Permit – not to exceed sixty months.

Signed ✗ date

Improvement Permit by: CS date 6/20/03

Authorization to Construct by: CS date 6/20/03

Installed by: Marty Tucker

Operation Permit by: CS date 9/17/03

Existing System Inspection by: date

HEALTH DEPT. COPY: WHITE OWNER COPY (FINAL): YELLOW OWNER COPY (INITIAL): PINK