11:00-11:30

IREDELL COUNTY HEALTH DEPARTMENT

STATESVILLE 704-878-5305 MOORESVILLE 704-664-5281

IMPROVEMENT PERMIT / AUTHORIZATION TO CONSTRUCT / OPERATION PERMIT / EXISTING SYSTEM INSPECTION

PERMIT# 105703 PIN# 4761022887.6 4761-03-4083 DATE 3/7/03

OWNER OR CONTRACTOR KIM RIVERA PHONE: Business 528-3320 Home

ADDRESS 144 BLUEGRASS CIRCLE MOORESVILLE NC 28117

LOCATION OSWALT AMITY - TR WEATHERS CREEK - TR TRAE CT - ON RT

SUBDIVISION RYAN WOODS BLOCK / SECTION LOT 6 LOT AREA .578AC SITE CLASS. PS DESIGN FLOW 360GPD L.T.A.R. .3GPD/FT2

Septic Tank: 1000 Gallons; STB 354 Date 8/15/02

Pump Tank: Gallons; PT Date

Pump Make: Model Serial No.

Nitrification Field: No Fields 1 Square Feet 900 Linear Feet 300

No Lines 6@50' Trench Width 36" Max Trench Bottom Depth 36" Gravel Depth N/A

☑ New System ☐ Repair System Type: I, II, III, IV, V, VI

System Description: GRAVITY 25% REDUCTION

Repair System Description: LP PANEL

Maintenance Agreement Required: ☐ Yes ☑ No

☑ House/Mod. Home No. Bedrooms 3

☐ Mobile Home No. Bathrooms 3

☐ Business No. Employees

☐ Other


☐ Slab ☑ Crawl Space ☐ Basement w/plumbing ☐ Basement wo/plumbing

Water Supply: ☑ Individual ☐ Public ☐ Community


Comments:/Conditions:

Comments:/Conditions:

INITIAL SITE SKETCH 1"=50'

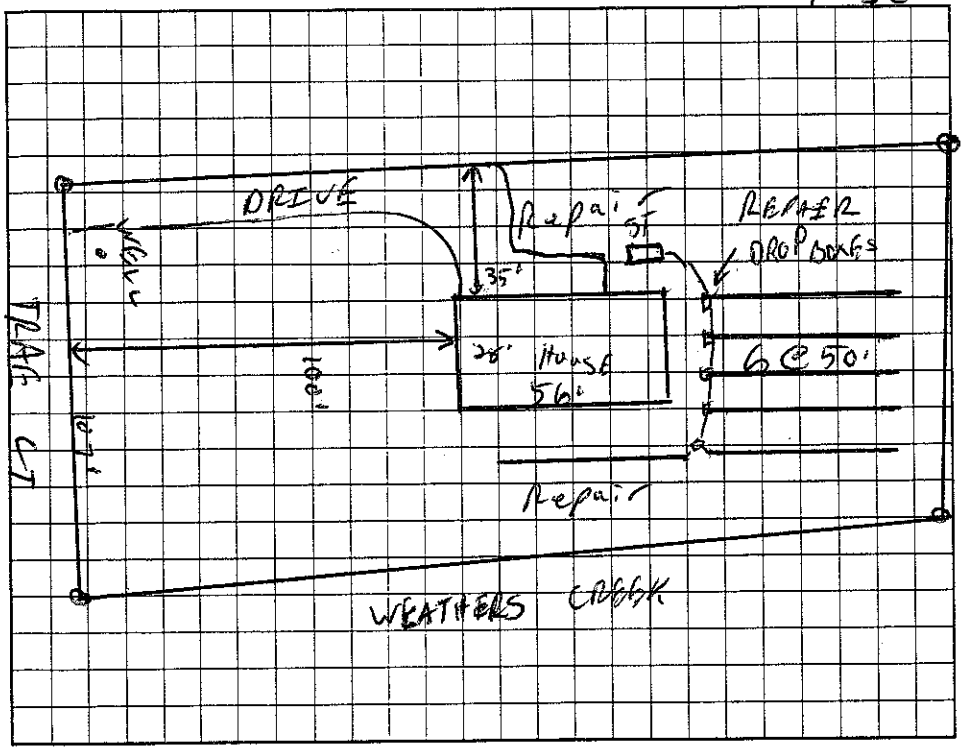

AS BUILT SKETCH

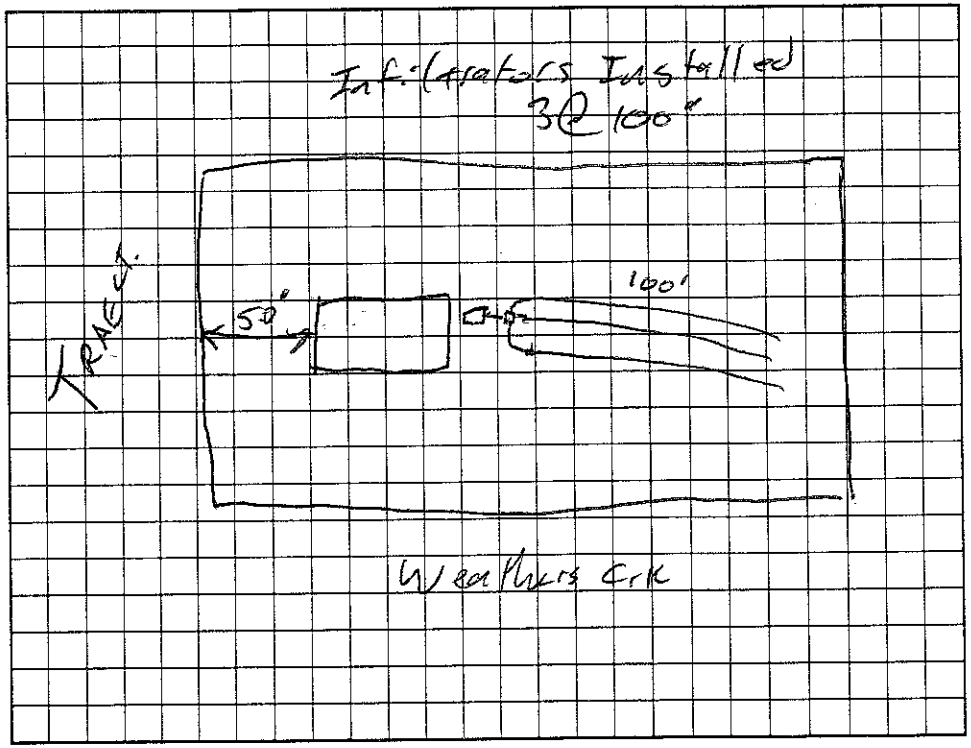

Permit can be suspended or revoked if any false information is supplied toward securing the permit/any unauthorized changes are made to the site/any unauthorized changes are made in the installation of the system. Improvement Permit with plat valid without expiration. Improvement Permit with site plan valid for sixty months. Authorization to Construct is valid for a period equal to that of Improvement Permit – not to exceed sixty months.

Signed: Scott S. Hylton date 3-7-03 Installed by: G & M Enterprises

Improvement Permit by: C. Hylton RS date 3/7/03 Operation Permit by: [signature] RS date 5/1/03

Authorization to Construct by: C. Hylton RS date 3/7/03 Existing System Inspection by: date

HEALTH DEPT. COPY: WHITE OWNER COPY (FINAL): YELLOW OWNER COPY (INITIAL): PINK