IREDELL COUNTY HEALTH DEPARTMENT

STATESVILLE 704-878-5305 CF MOORESVILLE 704-664-5281

IMPROVEMENT PERMIT / AUTHORIZATION TO CONSTRUCT / OPERATION PERMIT / EXISTING SYSTEM INSPECTION

PERMIT# 131507 PIN# 4761-03-6758 DATE 10-13-05

OWNER OR CONTRACTOR ~~TERESA NEWTON~~ Carl Hershberger PHONE: Business 704-363-6704 Home 828-478-2330

ADDRESS 925 SHEPHERDS ROAD, TROUTMAN NC 28166

LOCATION US 21 SOUTH TL OSWALT SMITH ROAD, ~ 4 MILES ON LEFT AT BOX #915

SUBDIVISION WESTMORELAND AC BLOCK / SECTION ____ LOT 1 LOT AREA 2.033 ACRES SITE CLASS. PSI DESIGN FLOW ~~440~~ 360 L.T.A.R. 0.25 GPD/FT²

Septic Tank: 1000 Gallons; STB 760 Date 8-26-05

Pump Tank: 1000 Gallons; PT 363 Date 9-20-05

Pump Make: ZOELLER Model BN 152-A Serial No. ____

Nitrification Field: No Fields 1 Square Feet 1920 Linear Feet 480

No Lines FOUR Trench Width 36" Max Trench Bottom Depth 36" Gravel Depth N/A

☑ New System ☐ Repair System ☐ CONVENTIONAL ☐ I ☐ II ☐ III ☐ IV, V, VI

System Description: 25% REDUCTION, PUMP

Repair System Description: 50% REDUCTION, LOW PRESSURE

Maintenance Agreement Required: ☐ Yes ☑ No ☐ Other ____

☑ House/Mod. Home No. Bedrooms 3

☐ Mobile Home No. Bathrooms ____

☐ Business No. Employees ____

☐ Slab ☑ Crawl Space ☐ Basement w/plumbing ☐ Basement wo/plumbing

Water Supply: ☑ Individual ☐ Public ☐ Community WELL

Comments/Conditions: ① SEE ATTACHED SHEETS FOR PUMP AND PRESSURE MANIFOLD REQUIREMENTS ② INSTALL 25% REDUCTION SYSTEM AS SHOWN/ CONVENTIONAL (FOR 3BR HOME)

Comments/Conditions: ③ Accepted systems may also be used. #11-3-05 Approved 3 BEDROOM PLAN 60X27. MAINTAIN SETBACKS.

INITIAL SITE SKETCH

SEE ATTACHED SITE PLAN BY ROLLANS SOIL & ENVIRONMENTAL SERVICES DATED OCTOBER 7, 2005

AS BUILT SKETCH

SEPTIC TANK WITH MARKER INSTALLED USING "ZABEL" FILTER, SYSTEM INSTALLED ACCORDING TO ATTACHED SITE PLAN BY ROLLANS SOIL & ENV. SERVICES.

	Date	Initials
Drain Lines Checked	1-20-06	RSH
Tanks Checked	1-20-06	RSH
Pressure Manifold or Valve Box Checked	1-20-06	RSH
Pressure Head Set	1-20-06	RSH
Electrical Checked	5/1/06	ALL
Floats Set	1-20-06	RSH
Alarm Checked	5-1-06	ALL
Maintenance Contract ~~Y~~ N	N/A	N/A

The proposed Dale Addn addition does not appear to impact the existing septic system.

**NOTE: ____ R.S.

Date: 1/20/10 ICHD-Environmental Health Division


Permit can be suspended or revoked if any false information is supplied toward securing the permit/any unauthorized system. Improvement Permit with plat valid without expiration. Improvement Permit with site plan valid for sixty months. Authorization to C... valid for a period equal to that of Improvement Permit, not to exceed sixty months.

Signed: Teresa Newton date ____ Installed by: ABEE'S GRADING

Improvement Permit by: STEVE HEDRICK date 10-13-05 Operation Permit by: ____ date 5-1-06

Authorization to Construct by: ____ date 11-3-05 Existing System Inspection by: ____ date ____

HEALTH DEPT. COPY: WHITE OWNER COPY (FINAL): YELLOW OWNER COPY (INITIAL): PINK

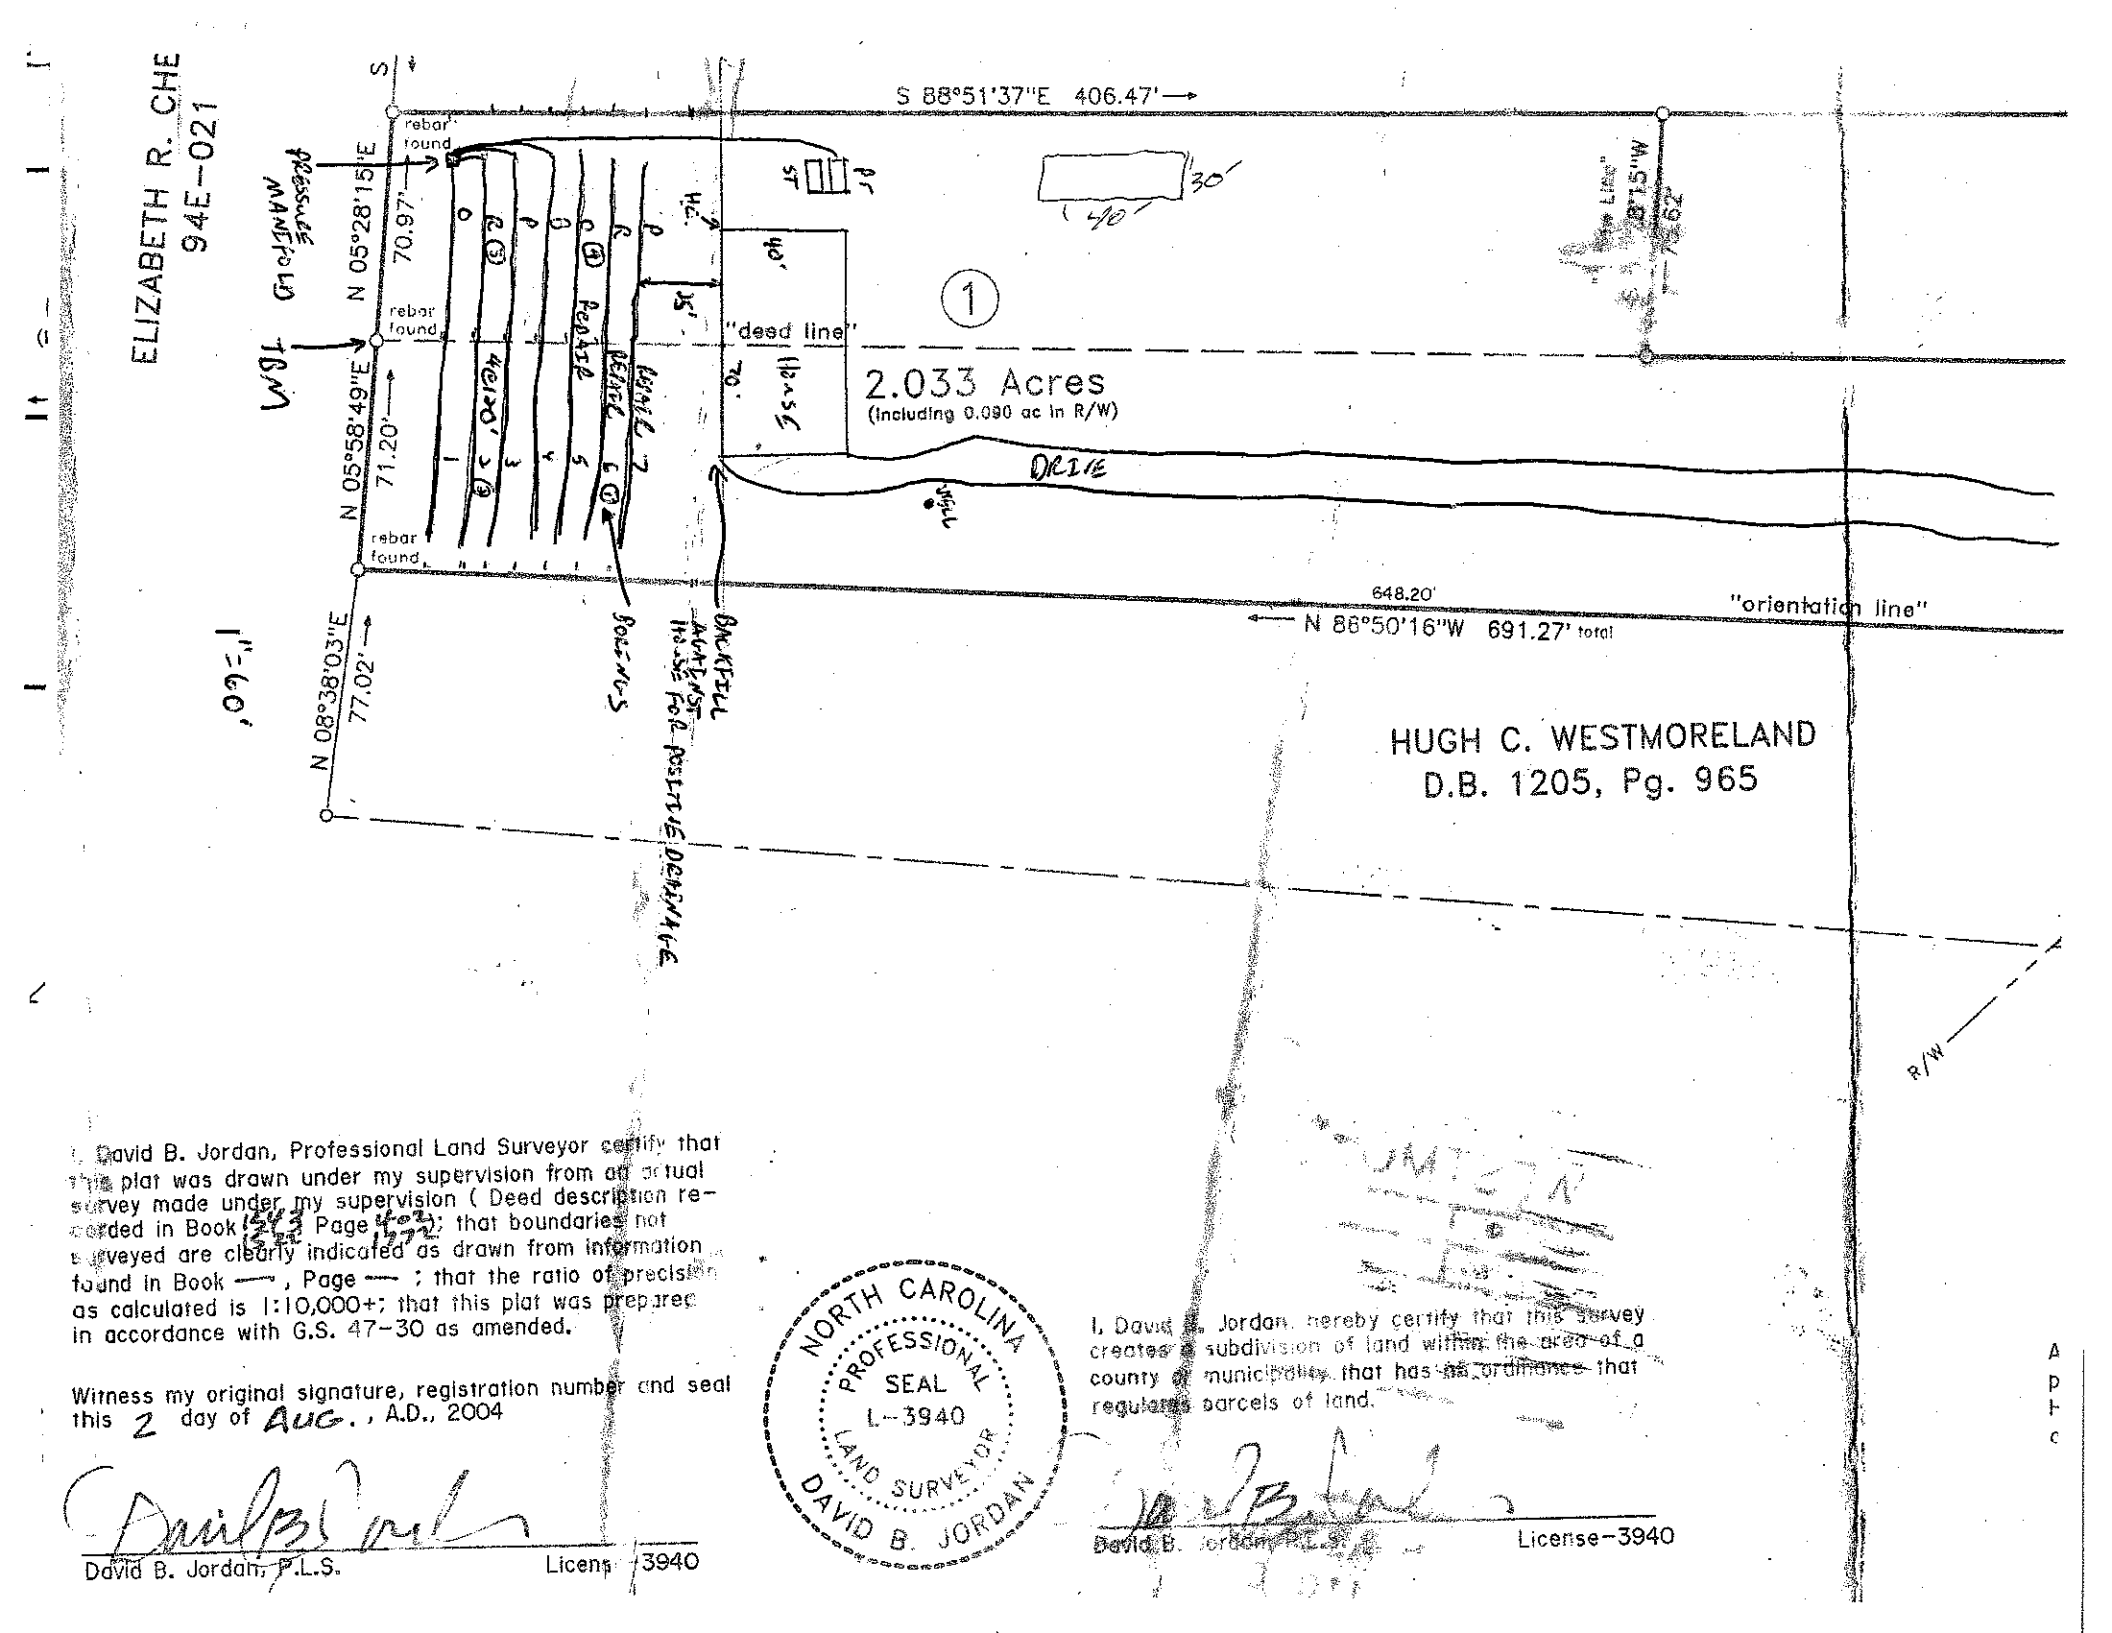

I, David B. Jordan, Professional Land Surveyor certify that this plat was drawn under my supervision from an actual survey made under my supervision (Deed description recorded in Book 1243, Page 1502; that boundaries not surveyed are clearly indicated as drawn from information found in Book —, Page —; that the ratio of precision as calculated is 1:10,000+; that this plat was prepared in accordance with G.S. 47-30 as amended.

Witness my original signature, registration number and seal this 2 day of AUG., A.D., 2004

David B. Jordan, P.L.S. License-3940

NORTH CAROLINA PROFESSIONAL SEAL L-3940 LAND SURVEYOR DAVID B. JORDAN

I, David B. Jordan, hereby certify that this survey creates a subdivision of land within the area of a county or municipality that has an ordinance that regulates parcels of land.

David B. Jordan, P.L.S. License-3940