IREDELL COUNTY HEALTH DEPARTMENT

Statesville Office (704) 878-5305 Mooresville Office (704) 660-3625 PERMIT # 208363

IMPROVEMENT PERMIT / AUTHORIZATION TO CONSTRUCT / OPERATION PERMIT / EXISTING SYSTEM

PIN # 4761071511

APPLICANT: Michael Nichols APPLICANT ADDRESS: 108 Apach trail Ln

SITE ADDRESS: 179 Starlight RD Statesville NC 28677 PHONE: 704-883-2296 ALT. PHONE: N/A

SITE DIRECTIONS: T/L Amity Hill Rd, Starlight Lot on left


SUBDIVISION: N/A SECTION: N/A LOT # N/A LOT AREA: 1.6 ac DESIGN FLOW: 240 L.T.A.R.: Ex

Septic Tank	Ex	(gal)	STB		Date		☐ New System	☐ Repair	☐ Expansion	System Type: I	II	III	IV	V	VI	☒ Residence	No. Bedrooms	2	Water Supply
Pump Tank		(gal)	PT		Date		System Description: Existing									☐ Business	No. Persons	4	☒ Private
Pump Make			Model		Serial #		Repair System Description:									☐ Other	No. Employees		☐ Public
# Nitrification Fields	Ex	# Lines	Ex	Linear Ft:	Ex		Maintenance Agreement Required:		☐ YES	☒ NO						☐ Slab	☒ Crawl Space		☐ Community
Trench Width	Ex	Max. Trench Bottom Depth	Ex	Gravel Depth	Ex		☒ GRAVITY	☐ PRESSURE								☐ Basement w/plumbing		☐ Basement w/o plumbing	

Comments / Conditions: All building foundations must be ≥ 25' from any well and 55' from any part of STS

INITIAL SITE SKETCH

AS BUILT SKETCH

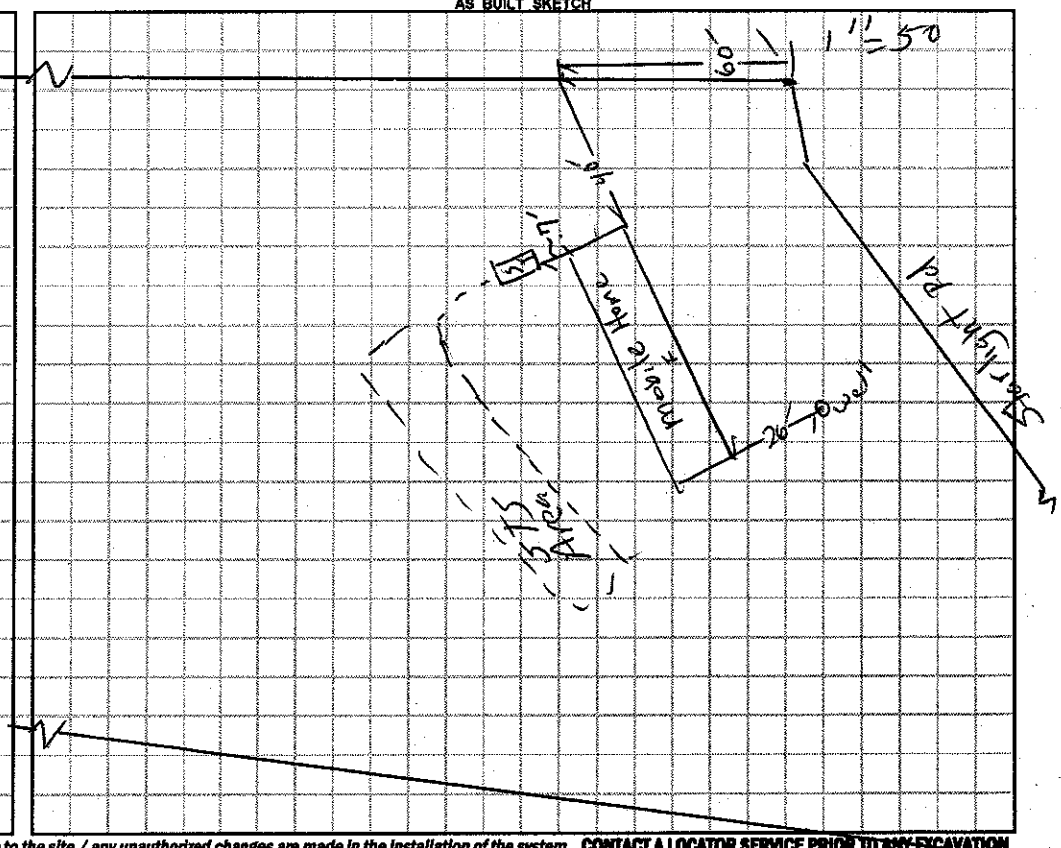

Permit can be suspended or revoked if any false information is supplied toward securing the permit / any unauthorized changes are made to the site / any unauthorized changes are made in the installation of the system. **CONTACT A LOCATOR SERVICE PRIOR TO ANY EXCAVATION**

☐ **IMPROVEMENT PERMIT** *with plat valid without expiration* ☐ **IMPROVEMENT PERMIT** *with site plan valid for 60 mos.* ☐ **AUTHORIZATION TO CONSTRUCT** *valid for period equal to IMPROVEMENT PERMIT--not to exceed 60 mo.*

Owner / Applicant Signature: [signature] Date: 3/24/15 Installed by:

IMPROVEMENT PERMIT by: Date: OPERATION PERMIT by: Date:

AUTHORIZATION TO CONSTRUCT by: Date: Existing System Inspected by: [signature] Date: 03/13/15

Health Dept. Copy - WHITE Applicant (Final Approval) - YELLOW Applicant (Conditional Approval) - PINK