IREDELL COUNTY HEALTH DEPARTMENT

STATESVILLE 704-878-5305 MOORESVILLE 704-664-5281

IMPROVEMENT PERMIT / AUTHORIZATION TO CONSTRUCT / OPERATION PERMIT / EXISTING SYSTEM INSPECTION

PERMIT# 106636 PIN# 4761 - 07-3917 DATE 6/5/02

OWNER OR CONTRACTOR William Bolling PHONE. Business Home (704) 634-7761

ADDRESS 122 Mount Mourne Lp Mooresville 28117

LOCATION Oswalt Amity, TL Amity Hill TR Star Light, Ncar End on Lt.

SUBDIVISION BLOCK / SECTION LOT LOT AREA 2.84C SITE CLASS PS DESIGN FLOW 360 L.T.A.R. 0.3

Septic Tank: 1600 Gallons; STB 1012 Date 2/7/02
Pump Tank: Gallons; PT Date
Pump Make: Model Serial No
Nitrification Field: No Fields 1 Square Feet 1200 Linear Feet 400
No Lines 4@100' Trench Width 36" Max Trench Bottom Depth 36" Gravel Depth 12"

X New System Repair System Type II
System Description Gravity Conventional Septic
Repair System Description
Maintenance Agreement Required Yes X No


House/Mod. Home No Bedrooms 3
X Mobile Home No Bathrooms 2
Business No Employees
Other
Slab X Crawl Space Basement w/plumbing Basement wo/plumbing

Water Supply: X Individual ☐ Public ☐ Community


Comments/Conditions:
Install lines on Contour

Comments/Conditions

INITIAL SITE SKETCH Not to scale

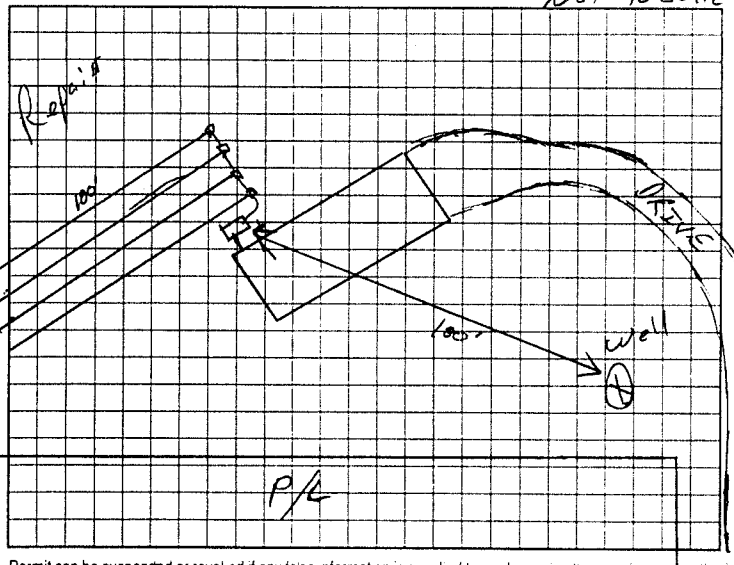

AS BUILT SKETCH

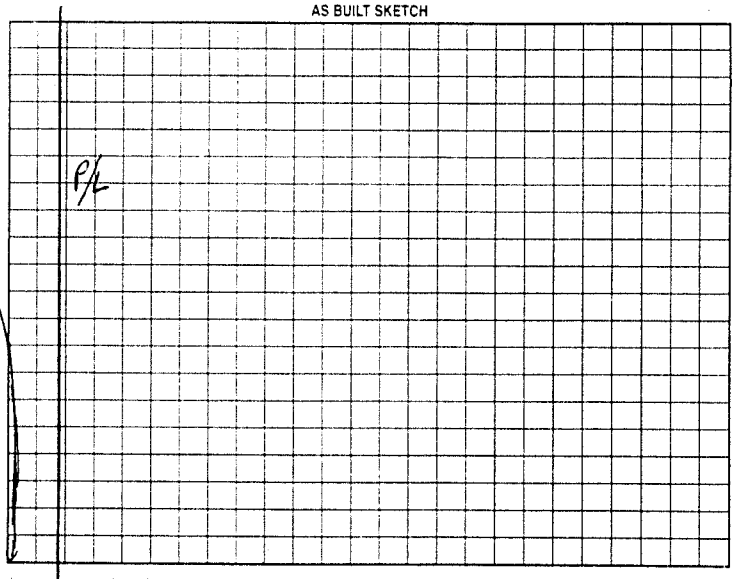

Permit can be suspended or revoked if any false information is supplied toward securing the permit; any unauthorized changes are made to the site any unauthorized changes are made in the installation of the system. Improvement Permit with plat valid without expiration. Improvement Permit with site plan valid for sixty months. Authorization to Construct is valid for a period equal to that of Improvement Permit - not to exceed sixty months.

Signed: Dennis Dahlen date 6-06-02 Installed by: A-1 Backhoe

Improvement Permit by: RS date 6/5/02 Operation Permit by: RS date 6/7/02

Authorization to Construct by: RS date 6/5/02 Existing System Inspection by: date

HEALTH DEPT COPY WHITE OWNER COPY (FINAL) YELLOW OWNER COPY (INITIAL) PINK