IREDELL COUNTY HEALTH DEPARTMENT

STATESVILLE 704-878-5305 MOORESVILLE 704-664-5281

IMPROVEMENT PERMIT / CERTIFICATE OF COMPLETION / OPERATION PERMIT / EXISTING SYSTEM INSPECTION

PROPERTY DESCRIPTION NO. 48652 DATE 9-5-97 TAX MAP NO. 4761 07 6778 Watershed: ☐ Yes ☐ No

OWNER OR CONTRACTOR Kevin Bence PHONE: Business _____ Home 528 3059

ADDRESS 207 Starlight Rd

LOCATION I-77 S TL Sanity Hill Cross 2nd Bike TL Starlight on left at end

SUBDIVISION _____ BLOCK / SECTION _____ LOT 7 LOT AREA 1 acre SITE CLASS. PS DESIGN FLOW 360 L.T.A.R. .43

Septic Tank: 1000 Gallons; STB 1012 Date 9-6-97

Pump Tank: _____ Gallons; PT _____ Date _____

Pump Make: _____ Model _____ Serial No. _____

Nitrification Field: No Fields 1 Square Feet 1206 Linear Feet 402

No Lines 4 Trench Width 36" Max Trench Bottom Depth 36" Gravel Depth 12"

☑ New System ☐ Repair System Type: I (II) III, IV, V, VI

System Description: Conv. Gravity

Repair System Description: Pump To Chambers

Maintenance Agreement Required: ☐ Yes ☐ No

☐ House/Mod. Home No. Bedrooms 3

☑ Mobile Home No. Bathrooms 2

☐ Business No. Employees _____

☐ Other _____


☐ Slab ☐ Crawl Space ☐ Basement w/plumbing ☐ Basement wo/plumbing

Water Supply: ☑ Individual ☐ Community ☐ Public

Comments:

Comments: Well + Home Not on Site at Time of This inspection Keep Property

INITIAL SITE SKETCH

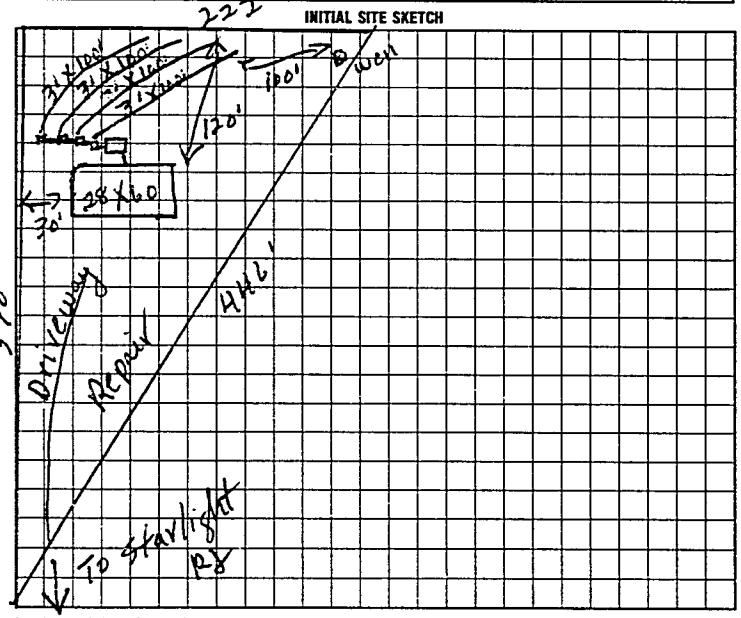

AS BUILT SKETCH Distances From Septic Tank System

Same as initial Sketch

I understand that this permit can be suspended or revoked if any false information is supplied toward securing the permit/any unauthorized changes are made to the site/any unauthorized changes are made in the installation of the system. Improvement Permit is valid for 60 months from date of issuance.

Signed: X Russell Dixon

Installed by: A-1 Backhoe

Improvement Permit by: C. C. Moore date 9-5-97

Certificate of Completion by: _____ date _____

Authorization to proceed by: C. C. Moore date 9-5-97

Operation Permit by: C. C. Moore date 9-16-97

HEALTH DEPT. COPY WHITE INSPECTION COPY (FINAL) GREEN OWNER COPY (FINAL) YELLOW INSPECTION COPY (INITIAL) PINK OWNER COPY (INITIAL) GOLD

to court - Authorization to court EXPIRES 60 MOS from issue

160800