IREDELL COUNTY HEALTH DEPARTMENT

STATESVILLE 704-878-5305 MOORESVILLE 704-664-5281

IMPROVEMENT PERMIT / AUTHORIZATION TO CONSTRUCT / OPERATION PERMIT / EXISTING SYSTEM INSPECTION

PERMIT# 144451 PIN# 4761 11 4792 DATE 8/10/07

OWNER OR APPLICANT Michelle McKay PHONE: Business _____ Home 704-799-3781

ADDRESS 116 Fox Glove Dr. Mooresville, NC. 28115

LOCATION Oswelt Cemetery TR Weathersbee Rd Fallen Acorn, 3RD lot on (R)

SUBDIVISION OAK RIDGE BLOCK / SECTION _____ LOT 28 LOT AREA 2.56 AC SITE CLASS. PS DESIGN FLOW 360 L.T.A.R. ≤ 3

Septic Tank: 1000 Gallons; STB 1007 Date 10-2-07
Pump Tank: _____ Gallons; PT _____ Date _____
Pump Make: _____ Model _____ Serial No. _____
Nitrification Field: No Fields 1 Square Feet 900 Linear Feet 300
No Lines 3@100' Trench Width 3' Max Trench Bottom Depth 3'

☒ New System ☐ Repair ☐ Expansion System Type: I II (III) IV V VI
System Description: Gravity - 25% Reduction
Repair System Description: Pressure - 25% Reduction
Maintenance Agreement Required: ☐ Yes ☒ No
Gravel Depth No ☒ Gravity ☐ Pressure

☒ House/Mod. Home ☐ Mobile Home ☐ Business ☐ Other _____
☐ Slab ☐ Crawl Space ☒ Basement w/plumbing ☐ Basement wo/plumbing


No. Bedrooms 3 No. Persons 6 No. Employees _____

Water Supply: ☒ Individual ☐ Public ☐ Community


Comments:/Conditions:

Comments:/Conditions: Bowco Co. Filter installed
Final grade should be within 6" from top of septic Tank

INITIAL SITE SKETCH

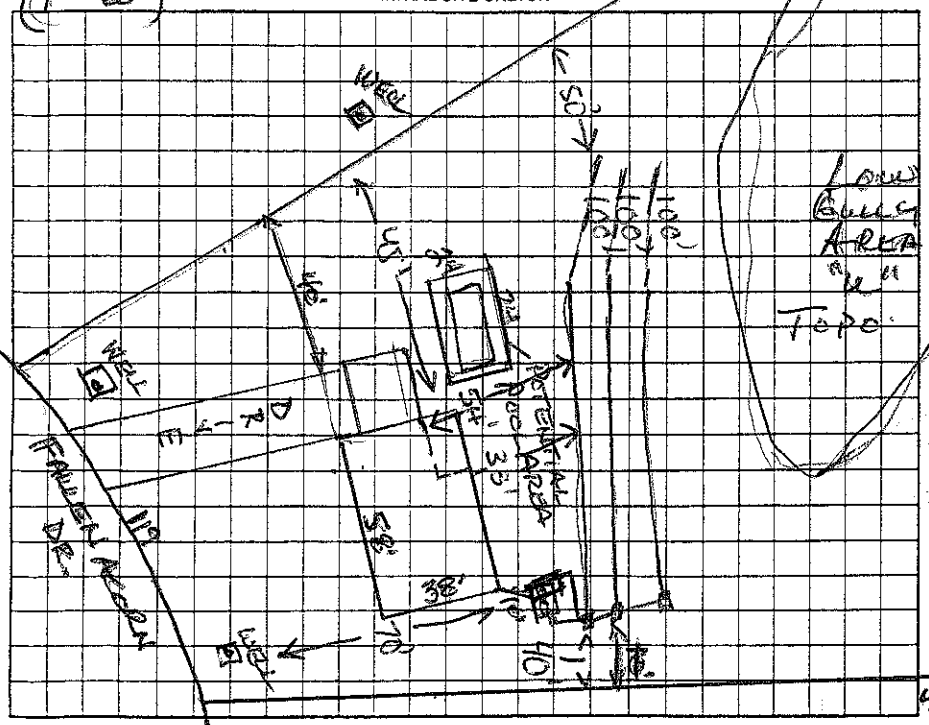

AS BUILT SKETCH

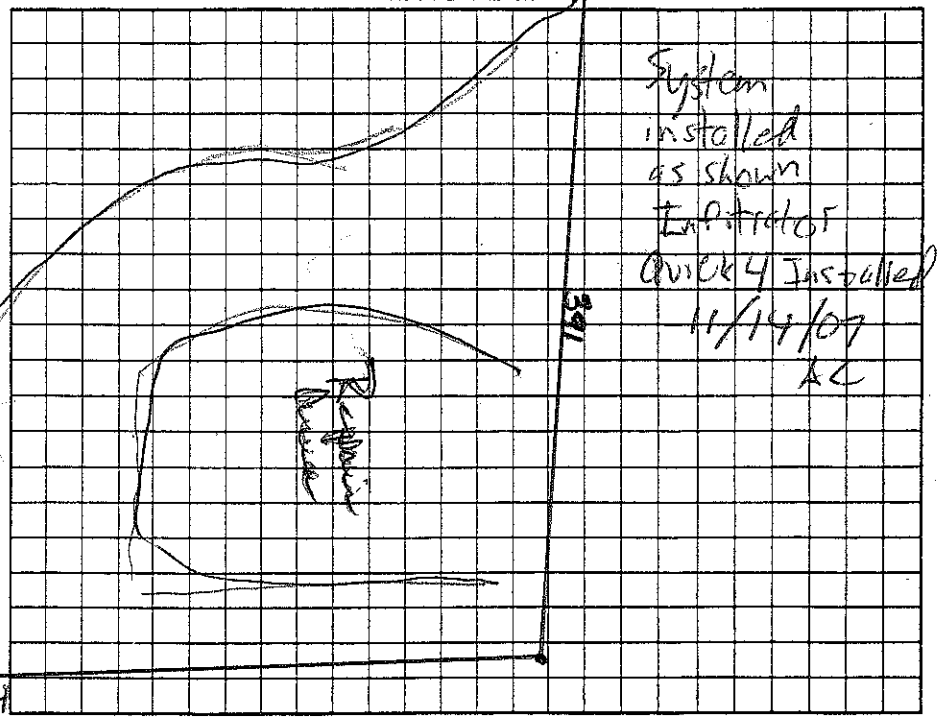

Permit can be suspended or revoked if any false information is supplied toward securing the permit/any unauthorized changes are made to the site/any unauthorized changes are made in the installation of the system. Improvement Permit with plat valid without expiration ☐ Improvement Permit with site plan valid for sixty months ☐ Authorization to Construct is valid for a period equal to that of Improvement Permit – not to exceed sixty months.

Signed: ✕ Chad Sellers date 8/14/07

Improvement Permit by: Wesley Sparks R.S. date 8/10/07

Authorization to Construct by: Wesley Sparks R.S. date 8/10/07

Installed by: Chris Ansell

Operation Permit by: Anthony Coker Jr. date 11/14/07

Existing System Inspection by: _____ date _____

HEALTH DEPT. COPY: WHITE OWNER COPY (FINAL): YELLOW OWNER COPY (INITIAL): PINK