ROWAN 3.30

IREDELL COUNTY HEALTH DEPARTMENT

STATESVILLE 704-878-5305 MOORESVILLE 704-664-5281

IMPROVEMENT PERMIT / AUTHORIZATION TO CONSTRUCT / OPERATION PERMIT / EXISTING SYSTEM INSPECTION

PERMIT# 138932 PIN# 4761121723 DATE 11/14/06

OWNER OR APPLICANT CAMPBELLS CARPENTRY CORP PHONE: Business 704 662-8676 Home

ADDRESS 137 PHEASANT RUN RD TROUTMAN NC 28166

LOCATION HWY 21/15 N, RT ON OSWALT AMITY, RT ON WEATHERS GAP, LT ON FALLEN ACORN ON LEFT

SUBDIVISION OAK RIDGE BLOCK / SECTION LOT 35 LOT AREA 2.413 Ac. SITE CLASS. P.S. DESIGN FLOW 480 gpd L.T.A.R. .275 gpd/ft² 2 wide trc

Septic Tank: 1000 Gallons; STB 825 Date 11/3/06
Pump Tank: Gallons; PT Date
Pump Make: Model Serial No.
Nitrification Field: No Fields 1 Square Feet 1320 Linear Feet 440
No Lines 4@110 Trench Width 36" Max Trench Bottom Depth 36"

☒ New System ☐ Repair ☐ Expansion System Type: I II ☒ III IV V VI
System Description: GRAVITY - 25% Reduction
Repair System Description: LP PANEL
Maintenance Agreement Required: ☐ Yes ☒ No
Gravel Depth N/A ☒ Gravity ☐ Pressure ☐ Slab ☐ Crawl Space ☒ Basement w/plumbing ☐ Basement wo/plumbing


☒ House/Mod. Home No. Bedrooms 4
☐ Mobile Home No. Persons
☐ Business No. Employees
☐ Other

Water Supply: ☒ Individual ☐ Public ☐ Community

Comments/Conditions: Fall from Tank to distribution should be between 1/4" and 1/8" drop per 10 FEET
-Remove burmes in drainfield area prior to installation


NOT TO SCALE

INITIAL SITE SKETCH

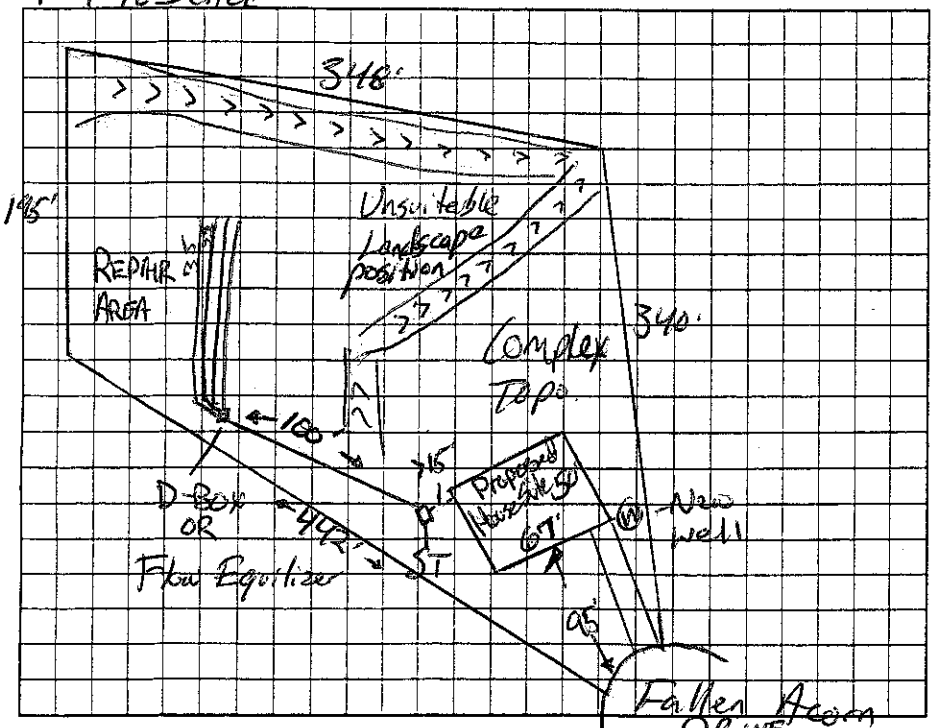

Comments/Conditions:

AS BUILT SKETCH

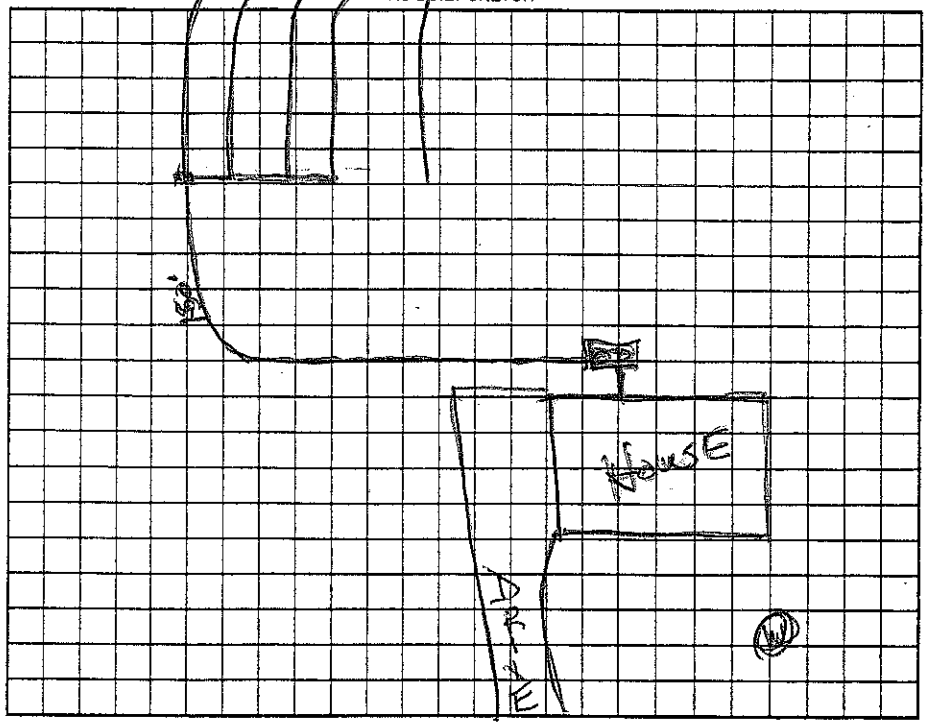

Permit can be suspended or revoked if any false information is supplied toward securing the permit/any unauthorized changes are made to the site/any unauthorized changes are made in the installation of the system. Improvement Permit with plat valid without expiration ☐ Improvement Permit with site plan valid for sixty months ☒ Authorization to Construct is valid for a period equal to that of Improvement Permit – not to exceed sixty months.

Signed: Jeffrey S Campbell Pres date

Improvement Permit by: Joseph E. Alpe date 11/14/06

Authorization to Construct by: Joseph E. Alpe date 11/14/06

Installed by: Rowan Septic Tank

Operation Permit by: Wesley Parks R.S. date 12/12/07

Existing System Inspection by: date

HEALTH DEPT. COPY: WHITE OWNER COPY (FINAL): YELLOW OWNER COPY (INITIAL): PINK