# IREDELL COUNTY HEALTH DEPARTMENT

STATESVILLE 704-878-5305 MOORESVILLE 704-664-5281

## IMPROVEMENT PERMIT / AUTHORIZATION TO CONSTRUCT / OPERATION PERMIT / EXISTING SYSTEM INSPECTION

PERMIT# 144193 PIN# 4761123152 DATE 7/24/07

OWNER OR APPLICANT TAF Design & Dev. Inc PHONE: Business 704-528-9060 Home

ADDRESS 152 Point of View Dr PO Box 5474 Mooresville 28117

LOCATION Osmith Amity (R) Weathers Cr. (L) on Fallen Acorn on left in Curve

SUBDIVISION OAK RIDGE BLOCK / SECTION 2 LOT 38 LOT AREA 1.156 Acre SITE CLASS. PS DESIGN FLOW 480 L.T.A.R. 30

Septic Tank: 1000 Gallons; STB 794 Date 10-21-07

Pump Tank: Gallons; PT Date

Pump Make: Model Serial No.

Nitrification Field: No Fields 1 Square Feet 1200 Linear Feet 400

No Lines 5@100' Trench Width 36 inch Max Trench Bottom Depth 36 inch Gravel Depth N/A

☒ New System ☐ Repair ☐ Expansion System Type: I II III IV V VI

System Description: 25% Reduction

Repair System Description: SAME/Pumped

Maintenance Agreement Required: ☐ Yes ☒ No

☒ House/Mod. Home ☐ Mobile Home ☐ Business ☐ Other


No. Bedrooms 4 No. Persons No. Employees

Water Supply: ☒ Individual ☐ Public ☐ Community

☒ Gravity ☐ Pressure ☐ Slab ☒ Crawl Space ☐ Basement w/plumbing ☐ Basement wo/plumbing

Comments:/Conditions:

INITIAL SITE SKETCH

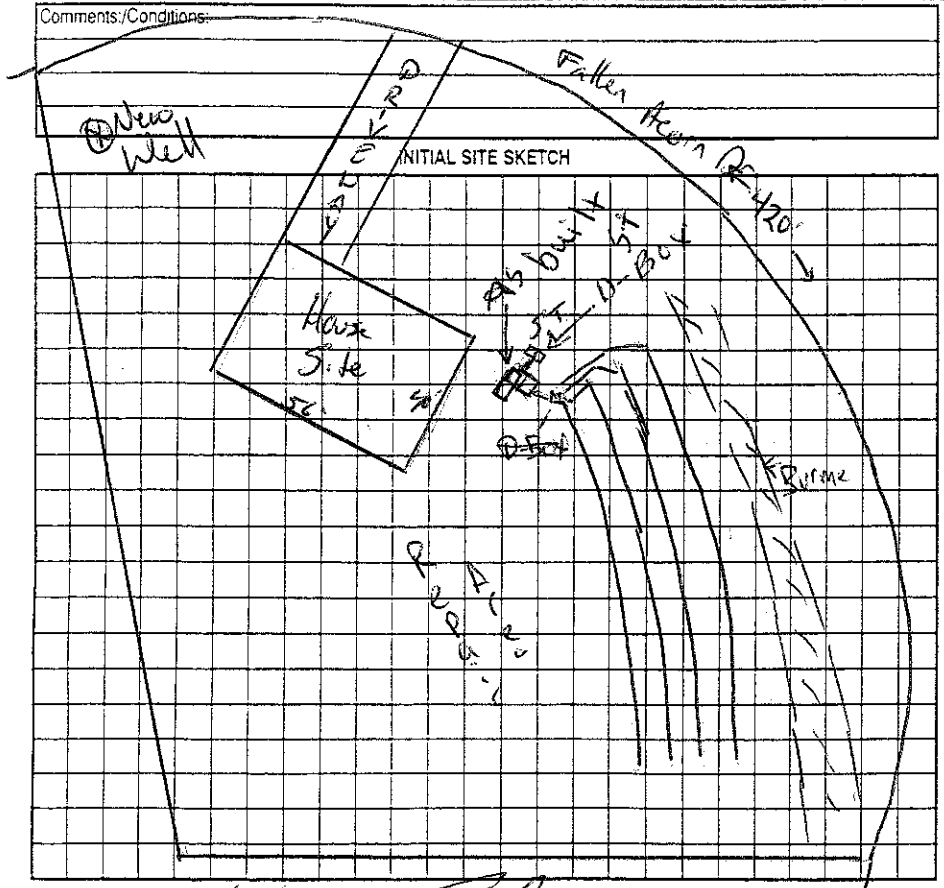


Comments:/Conditions: Red Polylok filter

AS BUILT SKETCH

Installed Quick 4 Infiltrator essentially as drawn

Lowest line 15'+ from embankment

Permit can be suspended or revoked if any false information is supplied toward securing the permit/any unauthorized changes are made to the site/any unauthorized changes are made in the installation of the system. Improvement Permit with plat valid without expiration ☐ Improvement Permit with site plan valid for sixty months ☐ Authorization to Construct is valid for a period equal to that of Improvement Permit – not to exceed sixty months.

Signed: date 8/1/07 Installed by: CD Roseman Grading & Hauling

Improvement Permit by: date 7/27/07 Operation Permit by: Geoffrey Melville date 2-15-08

Authorization to Construct by: date 7/27/07 Existing System Inspection by: date

HEALTH DEPT. COPY: WHITE OWNER COPY (FINAL): YELLOW OWNER COPY (INITIAL): PINK

Chris Roseman II