IREDELL COUNTY HEALTH DEPARTMENT

Statesville Office (704) 878-5305 Mooresville Office (704) 660-3625 PERMIT # 205098

IMPROVEMENT PERMIT / AUTHORIZATION TO CONSTRUCT / OPERATION PERMIT / EXISTING SYSTEM

PIN # 4761123229

APPLICANT: Daryl Dixon APPLICANT ADDRESS: Po Box 694 Mt. Ulla

SITE ADDRESS: 163 Fallen Acorn Dr. PHONE: 704-609-0429 ALT. PHONE: N/A

SITE DIRECTIONS: Hwy 115 to Ostwalt Amity Rd TR Weathers Creek TL Fallen Acorn Dr.

SUBDIVISION: Oak Ridge SECTION: 2 LOT # 37 LOT AREA: 1.007 acres DESIGN FLOW: 360gpd L.T.A.R.: 0.275


Septic Tank	1000 (gal)	STB	760	Date	11-4-14	☑ New System	☐ Repair	☐ Expansion	System Type: I II (III) IV V VI	☑ Residence	No. Bedrooms 3
Pump Tank	(gal)	PT		Date		System Description:	25% Reduction			☐ Business	No. Persons 6
Pump Make		Model		Serial #		Repair System Description:	50% Reduction			☐ Other	No. Employees
# Nitrification Fields	1	# Lines	4	Linear Ft:	328	Maintenance Agreement Required:	☐ YES	☑ NO		☑ Slab	☐ Crawl Space
Trench Width	36"	Max. Trench Bottom Depth	36"	Gravel Depth	N/A		☐ GRAVITY	☐ PRESSURE		☐ Basement w/plumbing	☐ Basement w/o plumbing

Water Supply: ☑ Private ☐ Public ☐ Community

Comments / Conditions: IMPROVEMENTS ONLY: Pump, Crush, & Fill Existing Septic Tank prior to issuance of CA; Install a 25% Reduction system on contour with serial distribution.

TANK CRUSHED AND FILLED BY GROUNDBREAKERS GRADING (SHANNON HENDERSON) 2/2/15

INITIAL SITE SKETCH

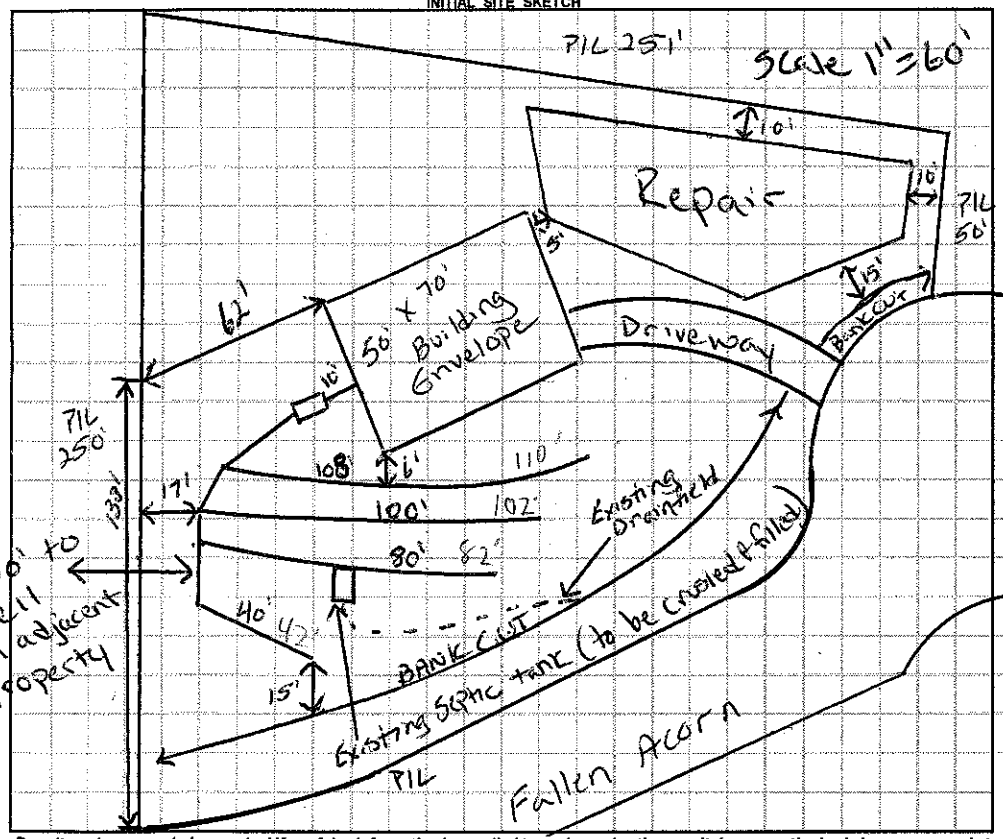

AS BUILT SKETCH

House DESIGN IS 70' x 53'. SHOULD BE OK TO NOT ENCROACH UPON SEPTIC AREA WITH HOUSE.

- IQ4W Installed, Installed as Drawn AKF 3-31-15
- With end caps line lengths are, from top to bottom 110', 102', 82', 42'.
- 110' from neighbors well

Permit can be suspended or revoked if any false information is supplied toward securing the permit / any unauthorized changes are made to the site / any unauthorized changes are made in the installation of the system. **CONTACT A LOCATOR SERVICE PRIOR TO ANY EXCAVATION**

☐ **IMPROVEMENT PERMIT** *with plat valid without expiration.* ☑ **IMPROVEMENT PERMIT** *with site plan valid for 60 mos.* ☑ **AUTHORIZATION TO CONSTRUCT** *valid for period equal to IMPROVEMENT PERMIT--not to exceed 60 mo.*

Owner / Applicant Signature: Wayne Dixon Date: Installed by: Ground Breakers

IMPROVEMENT PERMIT by: Justin Henderson Date: 9-16-14 OPERATION PERMIT by: Date: 3-31-15

AUTHORIZATION TO CONSTRUCT by: APPROVED MAR 05 2015 Date: Existing System Inspected by: Date:

Health Dept. Copy - WHITE Applicant (Final Approval) - YELLOW Applicant (Conditional Approval) - PINK