1-13

IREDELL COUNTY HEALTH DEPARTMENT

STATESVILLE 704-878-5305 MOORESVILLE 704-664-5281

IMPROVEMENT PERMIT / AUTHORIZATION TO CONSTRUCT / OPERATION PERMIT / EXISTING SYSTEM INSPECTION

PERMIT# 14220 | PIN# 4761125630 | DATE 5-22-07

OWNER OR APPLICANT America's Home Place, Inc. | PHONE: Business | Home

ADDRESS 168-D Norman Station Blvd, Mooresville NC 28117

LOCATION Hwy 115/R1 N, (R) Oswelt Amity (R) Weathers Creek, (R) Fallen Acorn → near end on right

SUBDIVISION Oak Ridge | BLOCK / SECTION | LOT 33 | LOT AREA 1.43 Acres | SITE CLASS. PS | DESIGN FLOW 480 | L.T.A.R. .3

Septic Tank: 1000 Gallons; STB 1000 Date 8/30/07
Pump Tank: Gallons; PT Date
Pump Make: Model Serial No.
Nitrification Field: No Fields 1 Square Feet 1200 Linear Feet 400
No Lines 4 @ 100 Trench Width 36" Max Trench Bottom Depth 36" Gravel Depth

☒ New System ☐ Repair ☐ Expansion System Type: I II III IV V VI
System Description: 25% Reduced
Repair System Description: Pump → 75% of 50% Red
Maintenance Agreement Required: ☐ Yes ☒ No
☒ Gravity ☐ Pressure


☒ House/Mod. Home ☐ Mobile Home ☐ Business ☐ Other
No. Bedrooms 4 No. Persons No. Employees
☐ Slab ☐ Crawl Space ☒ Basement w/plumbing ☐ Basement wo/plumbing

Water Supply: ☒ Individual ☐ Public ☐ Community


Comments/Conditions: 1) Lines & Tanks to be at least 10' from prop. lines, and 5' from house foundation 2) 4 lines @ 100' each 3) well to be at least 50' from system

Comments/Conditions:

INITIAL SITE SKETCH

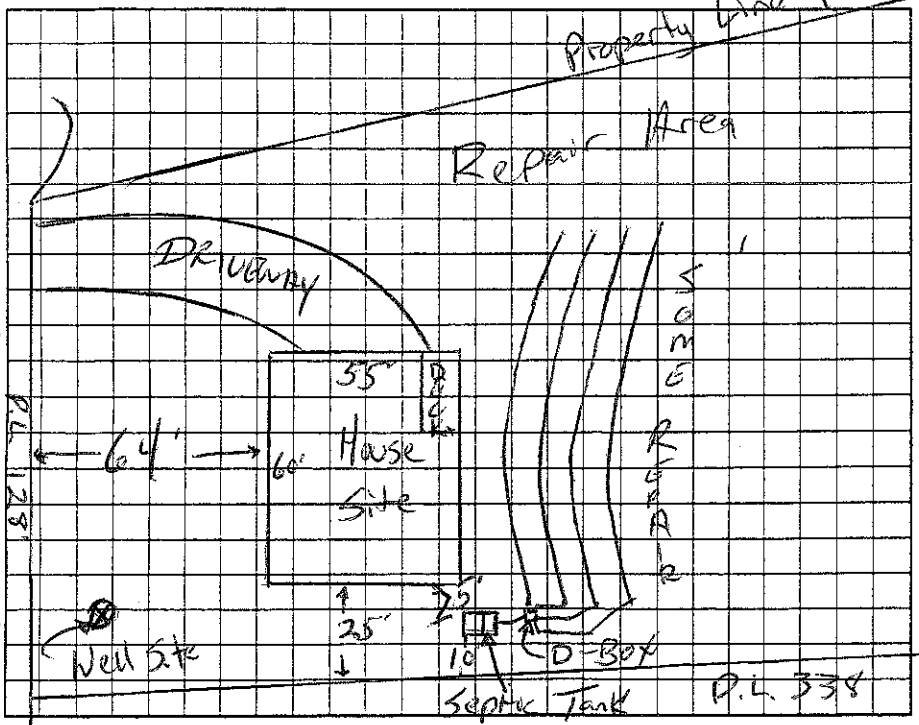

AS BUILT SKETCH

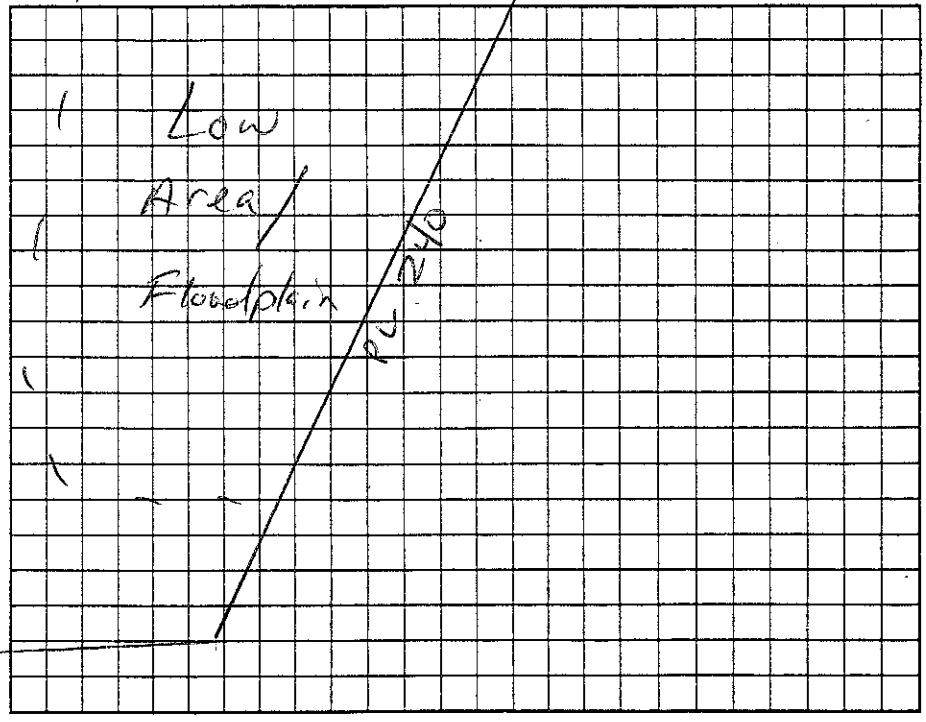

Permit can be suspended or revoked if any false information is supplied toward securing the permit/any unauthorized changes are made to the site/any unauthorized changes are made in the installation of the system. Improvement Permit with plat valid without expiration ☐ Improvement Permit with site plan valid for sixty months ☒ Authorization to Construct is valid for a period equal to that of Improvement Permit – not to exceed sixty months.

Signed: [signature] date 7/10/07 Installed by: K+M Grading + Backhoe

Improvement Permit by: Josh E Alph date 5-23-07 Operation Permit by: Wesley Sparks R.S. date 10/17/07

Authorization to Construct by: Josh E Alph date 5-23-07 Existing System Inspection by: date

HEALTH DEPT. COPY: WHITE OWNER COPY (FINAL): YELLOW OWNER COPY (INITIAL): PINK