IREDELL COUNTY HEALTH DEPARTMENT

STATESVILLE 704-878-5305 MOORESVILLE 704-664-5281

IMPROVEMENT PERMIT / AUTHORIZATION TO CONSTRUCT / OPERATION PERMIT / EXISTING SYSTEM INSPECTION

PERMIT# 14120 PIN# 4761127058 DATE 3-14-07

OWNER OR APPLICANT Jonathan Kiser PHONE: Business 309-0695 Home

ADDRESS 1 Hickory St SW Concord, NC 28027

LOCATION Hwy 21 North TR Oswalt Amity TR Weathers Creek TL Fallen Acorn On right

SUBDIVISION OAK RIDGE BLOCK / SECTION 30 LOT 30 LOT AREA 2.762 SITE CLASS. PS DESIGN FLOW 480gpd T.A.R. .3

Septic Tank: 1000 Gallons; STB 794 Date 6/26/07

Pump Tank: Gallons; PT Date

Pump Make: Model Serial No.

Nitrification Field: No Fields 1 Square Feet 1200 Linear Feet 400'

No Lines 4@100' Trench Width 36" Max Trench Bottom Depth 36"

☒ New System ☐ Repair ☐ Expansion System Type: I II III IV V VI

System Description: Gravity – 25% Reduction

Repair System Description: Same

Maintenance Agreement Required: ☐ Yes ☒ No

☐ House/Mod. Home ☒ Mobile Home ☐ Business ☐ Other

No. Bedrooms No. Persons No. Employees

Water Supply: ☒ Individual ☐ Public ☐ Community


Gravel Depth N/A ☒ Gravity ☐ Pressure ☐ Slab ☐ Crawl Space ☒ Basement w/plumbing ☐ Basement wo/plumbing

Comments/Conditions: Remove or "feather out" old berms


Comments/Conditions: "walk out" Basement, won't be cutting down lot in back

Scale 1:100

INITIAL SITE SKETCH

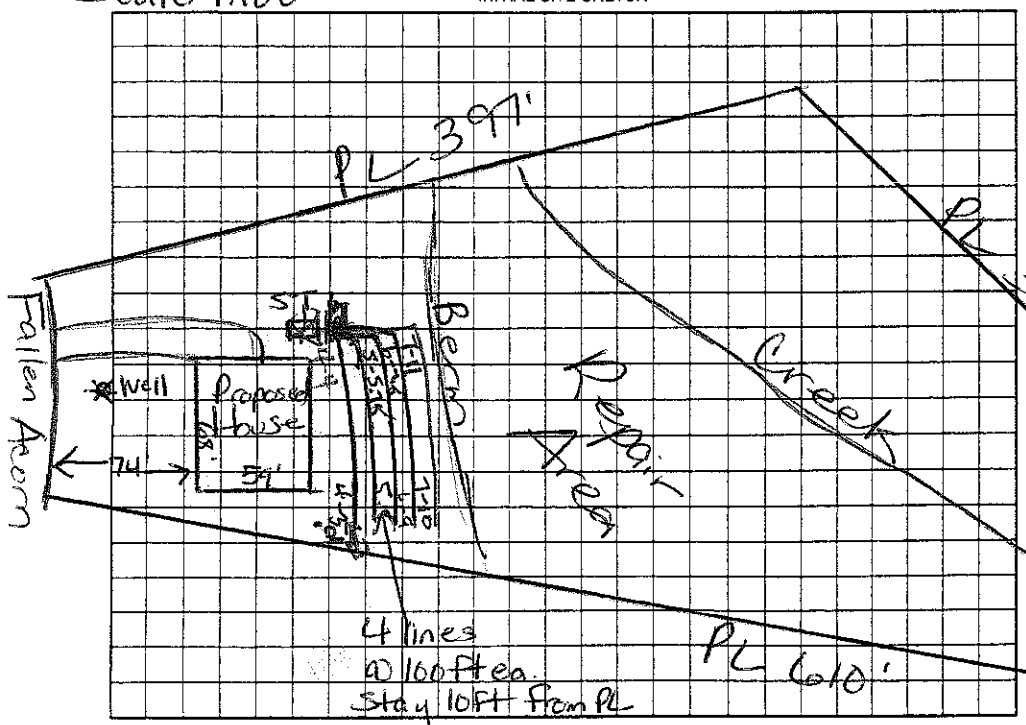

AS BUILT SKETCH

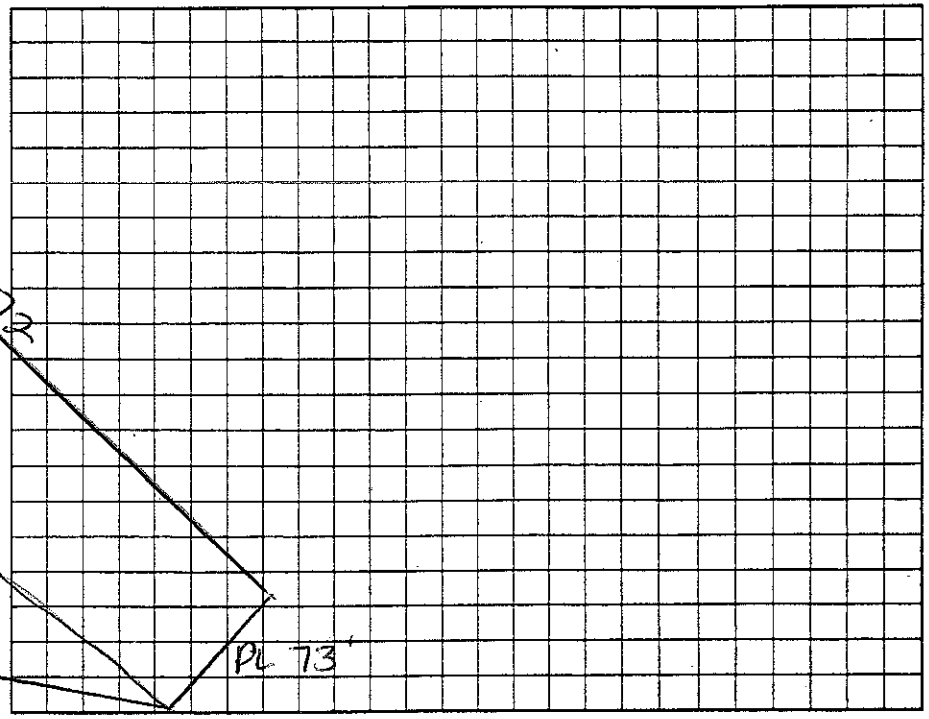

Permit can be suspended or revoked if any false information is supplied toward securing the permit/any unauthorized changes are made to the site/any unauthorized changes are made in the installation of the system. Improvement Permit with plat valid without expiration ☐ Improvement Permit with site plan valid for sixty months ☐ Authorization to Construct is valid for a period equal to that of Improvement Permit – not to exceed sixty months.

Signed: date 3-29-07 Installed by: Marty Tucker

Improvement Permit by: RS date 3/14/07 Operation Permit by: Wesley Sparks RS. date 8/9/07

Authorization to Construct by: RS date 3/14/07 Existing System Inspection by: date

HEALTH DEPT. COPY: WHITE OWNER COPY (FINAL): YELLOW OWNER COPY (INITIAL): PINK