IREDELL COUNTY HEALTH DEPARTMENT

STATESVILLE 704-878-5305 MOORESVILLE 704-664-5281

IMPROVEMENT PERMIT / AUTHORIZATION TO CONSTRUCT / OPERATION PERMIT / EXISTING SYSTEM INSPECTION

PERMIT# 140934 PIN# 4761127310 DATE 3-12-07

OWNER OR APPLICANT Blake Fox PHONE: Business (704) 883-2365 Home

ADDRESS 106 Wickford Lane Mathews, NC 28117

LOCATION Hwy 21 North TR Oswalt Amity Rd ~3 miles TR Weathers Creek Rd TL Falling Acorn lot on right

SUBDIVISION Oak Ridge BLOCK / SECTION LOT 31 LOT AREA 1.36 Acre SITE CLASS. PS DESIGN FLOW 480gpd L.T.A.R. .3

Septic Tank: 1000 Gallons; STB 794 Date 6/11/07

Pump Tank: Gallons; PT Date

Pump Make: Model Serial No.

Nitrification Field: No Fields 1 Square Feet 1200 Linear Feet 400

No Lines 4@100' Trench Width 36" Max Trench Bottom Depth 34" Gravel Depth N/A [X] Gravity ☐ Pressure

[X] New System ☐ Repair ☐ Expansion System Type: I (II) III IV V VI

System Description: Gravity - 25% Reduction

Repair System Description: Same

Maintenance Agreement Required: ☐ Yes [X] No

[X] House/Mod. Home ☐ Mobile Home ☐ Business ☐ Other

No. Bedrooms 4 No. Persons No. Employees

Water Supply: [X] Individual ☐ Public ☐ Community


☐ Slab ☐ Crawl Space [X] Basement w/plumbing ☐ Basement wo/plumbing

Comments:/Conditions: *Note: Okay to install Drainfield in 3 lines ~133 ft ea as long as linear feet = 400 ft.

Comments:/Conditions: 3@133' x 3'

Scale 1:60

INITIAL SITE SKETCH

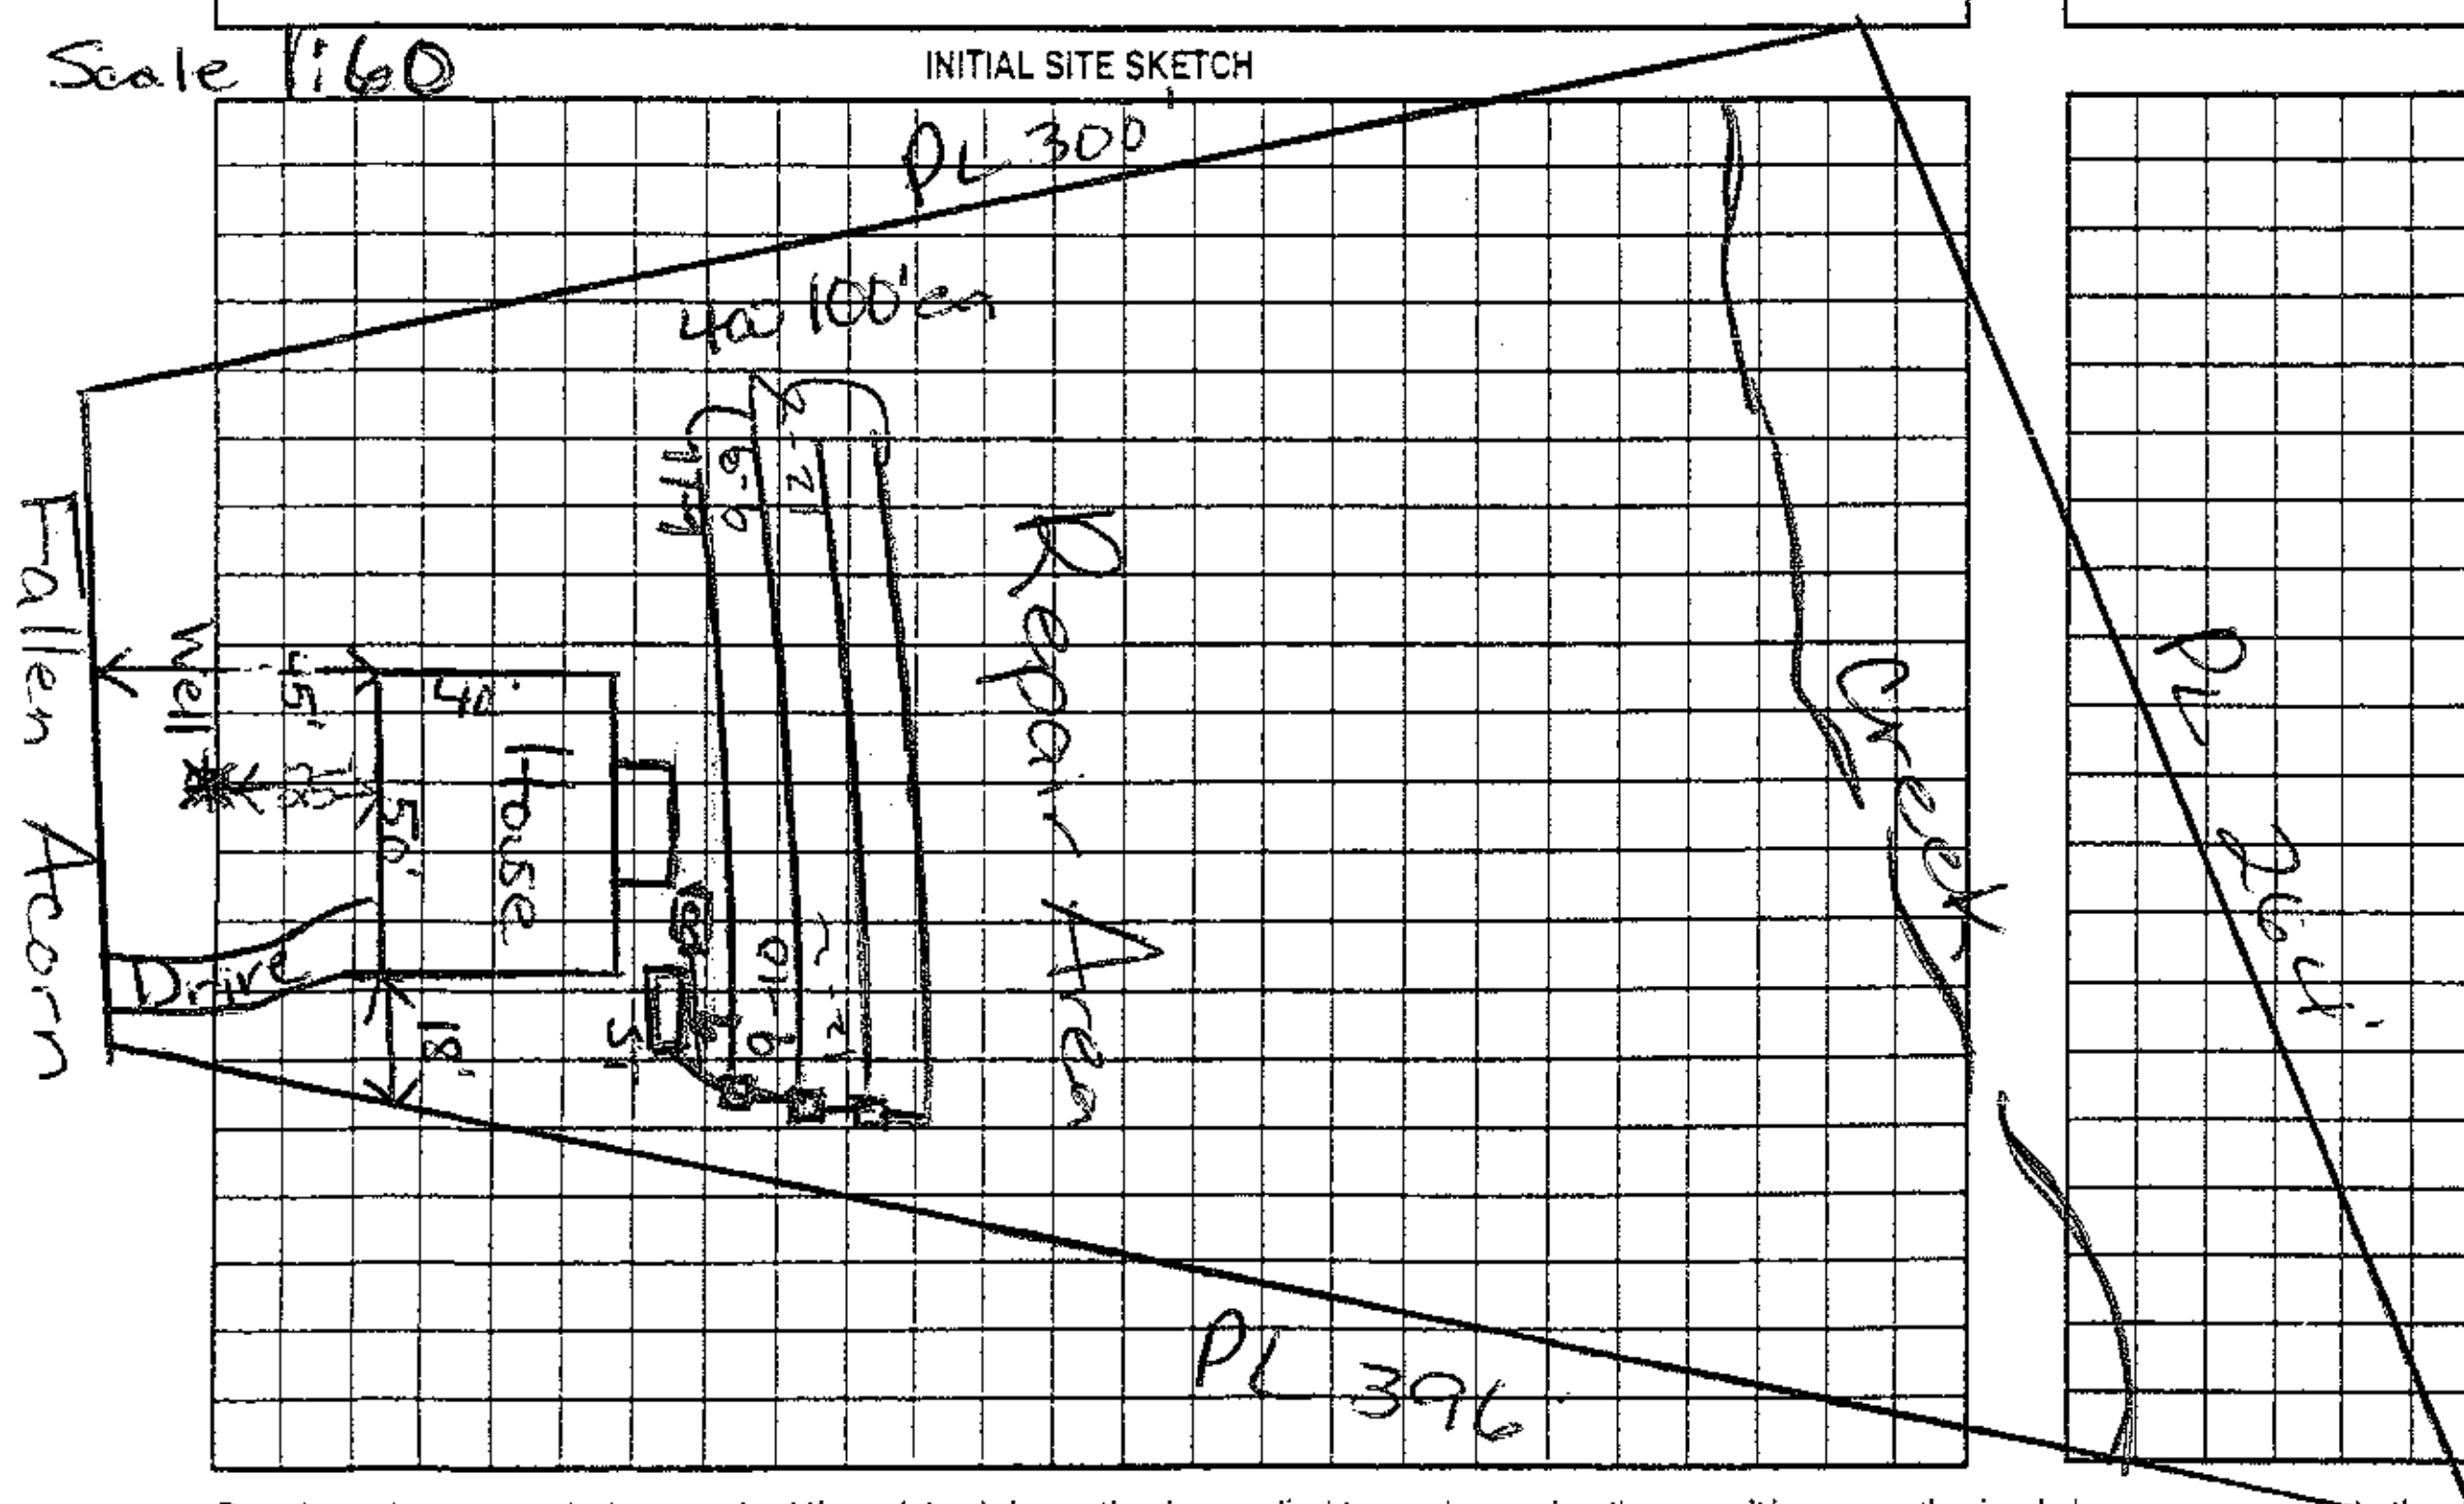

AS BUILT SKETCH

Permit can be suspended or revoked if any false information is supplied toward securing the permit/any unauthorized changes are made to the site/any unauthorized changes are made in the installation of the system. Improvement Permit with plat valid without expiration ☐ Improvement Permit with site plan valid for sixty months ☐ Authorization to Construct is valid for a period equal to that of Improvement Permit – not to exceed sixty months.

Signed: [signature] date 3-13-07

Improvement Permit by: Maria H. Dobson RS date 3/12/07

Authorization to Construct by: Maria H. Dobson RS date 3/12/07

Installed by: Marty Tucker

Operation Permit by: Wesley Sparks R.S. date 8/9/07

Existing System Inspection by: date

HEALTH DEPT. COPY: WHITE OWNER COPY (FINAL): YELLOW OWNER COPY (INITIAL): PINK