4761130236

___ COUNTY HEALTH DEPARTMENT

STATESVILLE 704-878-5305 MOORESVILLE 704-664-5281

IMPROVEMENT PERMIT / CERTIFICATE OF COMPLETION / OPERATION PERMIT / EXISTING SYSTEM INSPECTION

PROPERTY DESCRIPTION NO. 16491 DATE 6/11/93 TAX MAP NO. 58 A 106

OWNER OR CONTRACTOR BARBARA SANDLER PHONE: Business Home 528-3358

ADDRESS OSWALT AMITY RD.

LOCATION ON (R) OF OSWALT AMITY JUST PAST WEATHERCREEK RD. (R), (R) TO END OF DRIVE

SUBDIVISION ISADORA HEGGINS BLOCK / SECTION LOT ? LOT AREA 1.06 AC SITE CLASS. P L.T.A.R. .3 - .35

Water Supply: ☑ Individual ☐ Community ☐ Public

Septic Tank: 1000 Gallons; STB 358 Date 8/23/93

Pump Tank: Gallons; PT Date

Nitrification Field: No. Fields 1 Square Feet 720 Linear Feet 240

No. Lines 4 AWS Trench Width 3 Trench Depth 36" Gravel Depth 12"

☑ New System ☐ Repair System Type: I, II, (III) IV, V, VI

System Description: CONV.

Repair System Description: CONV.

Maintenance Agreement Required: ☐ Yes ☑ No

☐ House/Mod. Home ☑ Mobile Home ☐ Business ☐ Other

No. Bedrooms X3 AWS No. Bathrooms 2 No. Employees

☐ Slab ☑ Crawl Space ☐ Basement w/plumbing ☐ Basement wo/plumbing

Garbage Disposal: ☐ Yes ☑ No


Auto. Dishwasher: ☑ Yes ☐ No

Auto. Washing Machine: ☑ Yes ☐ No

Other

Comments TRENCHES NO DEEPER THAN 36"
LINES ON SLOPE CONTOUR IN DIRECTION SHOWN
9/29/93 - CHANGED TO 3BD. PER PHONE CON WITH DEBBIE CLARK, ADDITIONAL LINE WILL BE REQUIRED.

INITIAL SITE SKETCH

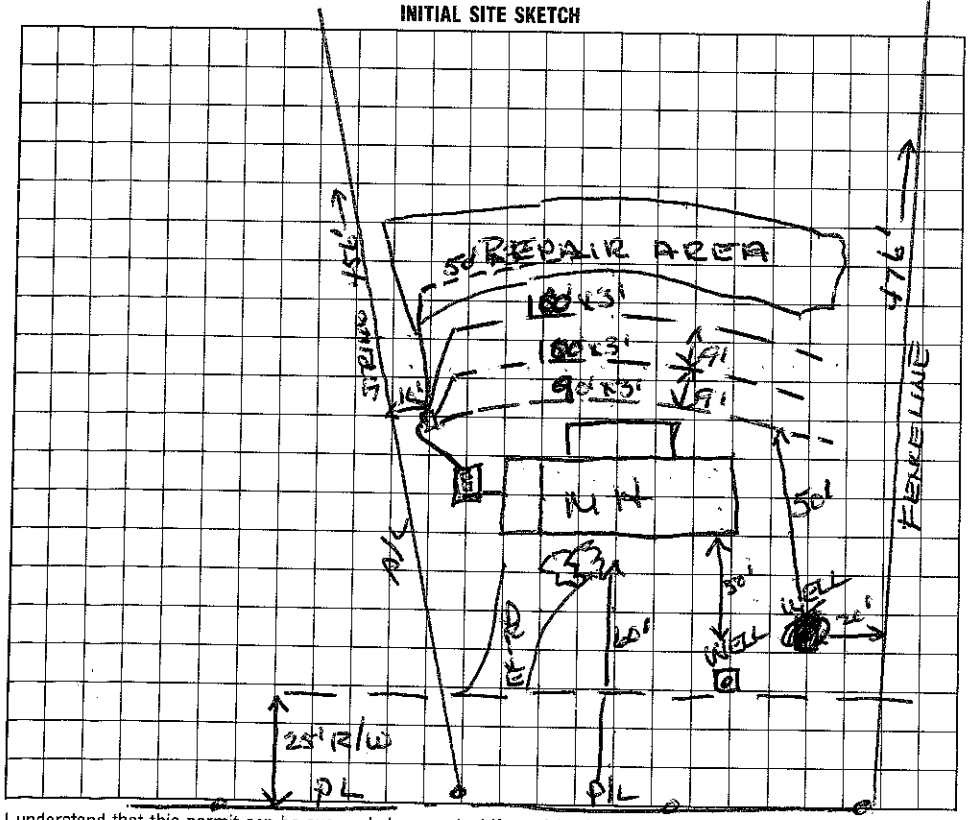

AS BUILT SKETCH

INSTALLED AS DRAWN!

9/30/93 AWS.

I understand that this permit can be suspended or revoked if any false information is supplied toward securing the permit/any unauthorized changes are made to the site/any unauthorized changes are made in the installation of the system. Improvement Permit is valid for 60 months from date of issuance.

Signed: Barbara Ann Sandler

Improvement Permit by: Wesley Sparks RS. date 6/11/93

Existing System Inspection by: date

Installed by: Donald Lackey

Certificate of Completion by: Wesley Sparks RS. date 9/30/93

Operation Permit by: date

HEALTH DEPT. COPY: WHITE INSPECTION COPY (FINAL): GREEN OWNER COPY (FINAL): YELLOW INSPECTION COPY (INITIAL): PINK OWNER COPY (INITIAL): GOLD