Redraw owes 1210.00 COPY

IREDELL COUNTY HEALTH DEPARTMENT

STATESVILLE 704-878-5305 MOORESVILLE 704-664-5281

IMPROVEMENT PERMIT / AUTHORIZATION TO CONSTRUCT / OPERATION PERMIT / EXISTING SYSTEM INSPECTION

PERMIT# 147794 PIN# 4761331124.003 4761-13-8951 DATE 8/6/08

OWNER OR APPLICANT Corinthian Builders Ltd. PHONE: Business 704 400-1258 Home

ADDRESS PO Box 990 Denver NC 28037

LOCATION Hwy 21 to TR Oswalt Amity TR Wheatfield Lot on Rt

SUBDIVISION Wheatfield BLOCK / SECTION 1 LOT 3 LOT AREA 24,807 ft² SITE CLASS. PS DESIGN FLOW 360 L.T.A.R. .275

Septic Tank: 1000 Gallons; STB 786 Date 3/27/08
Pump Tank: 1000 Gallons; PT 32 Date 3/14/08
Pump Make: Goulds Model WE0511HH Serial No. 96736587
Nitrification Field: No Fields 1 Square Feet 1011 Linear Feet 337
No Lines 5 Trench Width 36" Max Trench Bottom Depth 18" Gravel Depth

☒ New System ☐ Repair ☐ Expansion System Type: I II (III) IV V VI
System Description: PM 25% Reduction
Repair System Description: PM 25% Reduction
Maintenance Agreement Required: ☐ Yes ☒ No

☐ Gravity ☒ Pressure ☐ Slab ☐ Crawl Space ☐ Basement w/plumbing ☐ Basement wo/plumbing

☒ House/Mod. Home ☐ Mobile Home ☐ Business ☐ Other


No. Bedrooms 3 No. Persons No. Employees

Water Supply: ☒ Individual ☐ Public ☐ Community

Comments:/Conditions: Permit redrawn from original S&EC plan because system was installed too deep, used area between trenches to re install system and relocate repair area.

Comments:/Conditions: Drain lines checked 6/6/08 Tanks checked 6/6/08 Pressure & PM checked 7/3/08

INITIAL SITE SKETCH 191.76' 1" = 50'

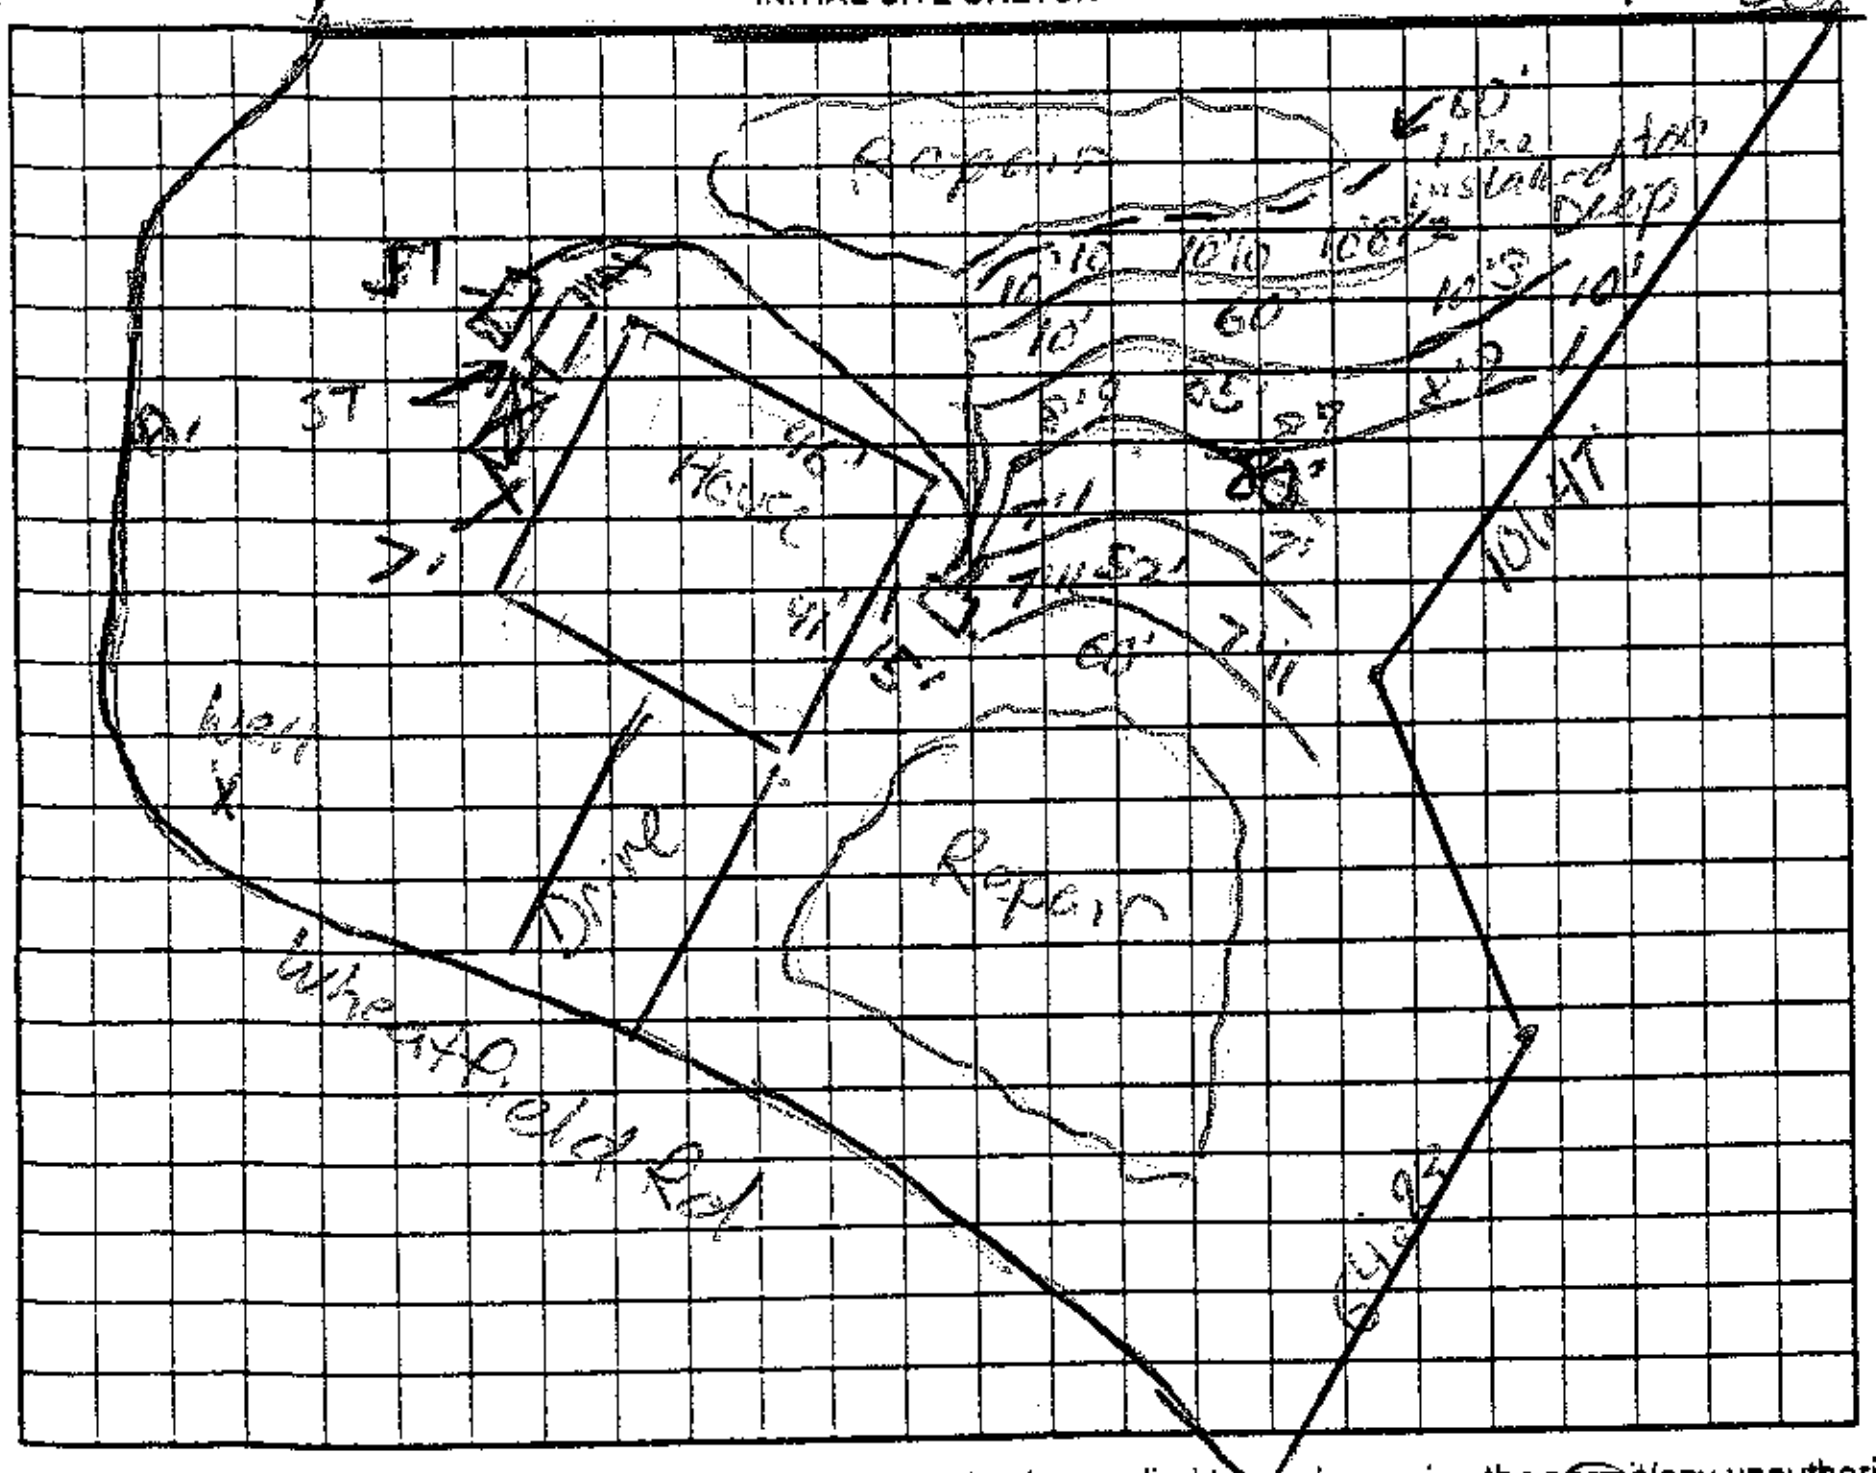

AS BUILT SKETCH

System installed as shown

Electrical checked 8/5/08

Permit can be suspended or revoked if any false information is supplied toward securing the permit/any unauthorized changes are made to the site/any unauthorized changes are made in the installation of the system. Improvement Permit valid without expiration ☐ Improvement Permit with site plan valid for sixty months ☒ Authorization to Construct is valid for a period equal to that of Improvement Permit – not to exceed sixty months.

date 8-8-08

by: Anthony Coker Jr. R.S. date 8/6/08

Construct by: Anthony Coker Jr. R.S. date 8/6/08

Installed by: Corinthian Builders

Operation Permit by: Anthony Coker Jr. R.S. date 8/6/08

Existing System Inspection by: date


HEALTH DEPT. COPY: WHITE OWNER COPY (FINAL): YELLOW OWNER COPY (INITIAL): PINK

AUG-05-2008(TUE) 09:14 DEDMON SURVEYORS (FAX)704 483 2170 P. 003/003

NOTES:
- PROPERTY MAY BE SUBJECT TO RECORDED OR UNRECORDED RIGHTS OF WAYS OR EASEMENTS NOT OBSERVED
- OWNER TO VERIFY ALL SETBACKS AND ZONING REGULATIONS PRIOR TO ANY PLANNING OR CONSTRUCTION.
- THIS PROPERTY DOES NOT LIE WITHIN A SPECIAL FLOOD HAZARD AREA AS DETERMINED BY THE FEDERAL EMERGENCY MANAGEMENT AGENCY.

Curve	Radius	Length	Chord	Chord Bear.
C1	255.00'	37.56'	37.53'	S 47°53'28" E
C2	255.00'	98.84'	98.22'	S 63°12'56" E
C3	25.00'	35.23'	32.39'	S 33°56'38" E
C4	25.00'	21.81'	21.13'	S 31°25'45" W
C5	45.00'	18.07'	17.95'	S 44°55'17" W

Course	Bearing	Distance
L1	S 43°40'13" E	9.68'

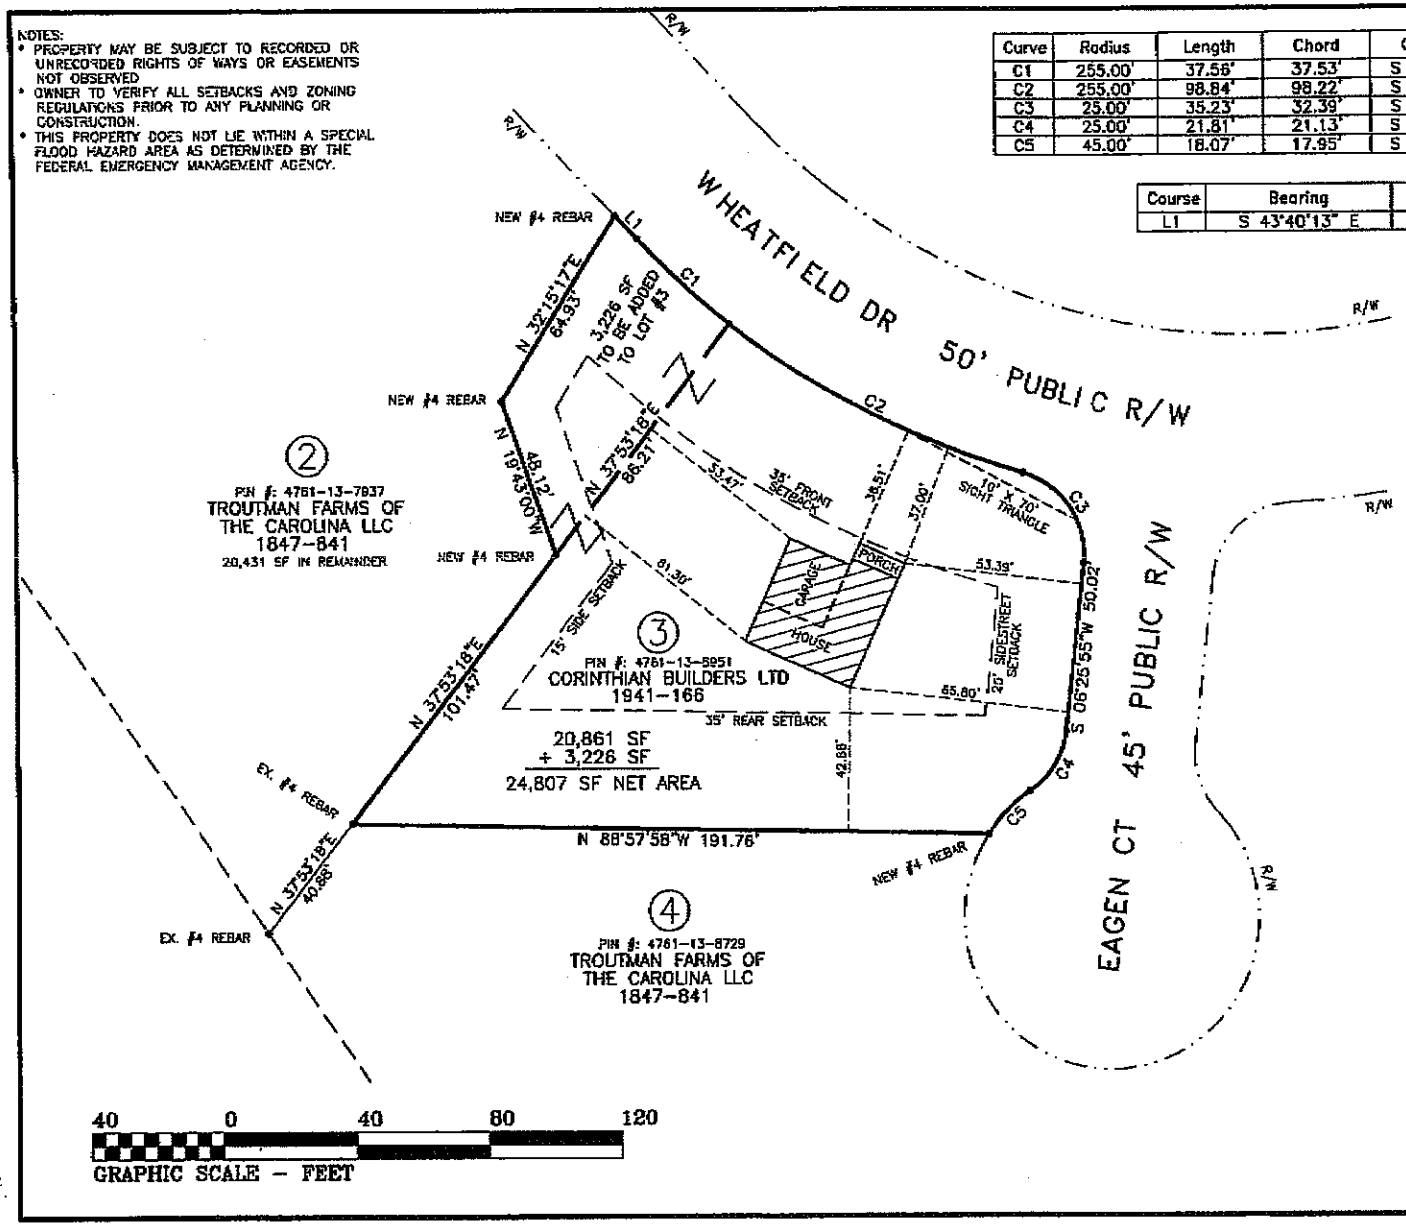

PHYSICAL SURVEY FOR

CORINTHIAN BUILDERS LTI

BEING A BOUNDARY LINE ADJUSTMENT FOR LOT OF WHEATFIELD SUBDIVISION, PHASE 1

DATE: JUNE 25, 2008
SCALE: 1" = 40'

DB: 1941 PG: 16
DB: 1847 PG: 84
PB: 54 PG: 47

CHAMBERSBURG TOWNSHIP
IREDELL COUNTY, NORTH CAROLINA

DEDMON SURVEYS
RONNIE DEDMON, PLS #1222
CHUCK POOVEY, PLS #3762
ROBERT DEDMON, PLS #3899
PHILLIP HARRIS, PLS #4164
4837 NC HIGHWAY #16 NORTH
P.O. BOX 494 - DENVER, NC 2803
PHONE: 704/483/4908
FAX: 704/483/2170

NORTH CAROLINA PROFESSIONAL SEAL L-4164 LAND SURVEYOR PHILLIP A. HARRIS

I CERTIFY THIS PLAT WAS DRAWN FROM AN ACT SURVEY AND IS CORRECT AND TRUE TO THE BE OF MY KNOWLEDGE.

Phillip A. Harris 4164
PROFESSIONAL LAND SURVEYOR LICENSE

SURV. BY: BC | DRAWN: PH | JOB# P208

VICINITY MAP

