Redraw owes 1210.00

IREDELL COUNTY HEALTH DEPARTMENT

STATESVILLE 704-878-5305 MOORESVILLE 704-664-5281

IMPROVEMENT PERMIT / AUTHORIZATION TO CONSTRUCT / OPERATION PERMIT / EXISTING SYSTEM INSPECTION

PERMIT# 147794 PIN# 4761331124.003 4761-13-8951 DATE 8/6/08

OWNER OR APPLICANT Corinthian Builders Ltd. PHONE: Business 704 400-1258 Home

ADDRESS PO Box 990 Denver NC 28037

LOCATION Hwy 21 N TR Oswalt Amity TR Wheatfield Lot on R7

SUBDIVISION Wheatfield BLOCK / SECTION 1 LOT 3 LOT AREA 24,807 Ft² SITE CLASS. PS DESIGN FLOW 360 L.T.A.R. 2275

Septic Tank: 1000 Gallons: STB 786 Date 3/27/08

Pump Tank: 1000 Gallons: PT 32 Date 2/14/08

Pump Make: Goulds Model WE05114HT Serial No. 96673587

Nitrification Field: No Fields 1 Square Feet 1011 Linear Feet 337

No Lines 5 Trench Width 36" Max Trench Bottom Depth 18" Gravel Depth ☐ Gravity ☑ Pressure

☑ New System ☐ Repair ☐ Expansion System Type: I II III IV V VI

System Description: PM 25% Reduction

Repair System Description: PM 25% Reduction

Maintenance Agreement Required: ☐ Yes ☑ No

☑ House/Mod. Home ☐ Mobile Home ☐ Business ☐ Other

No. Bedrooms 3 No. Persons ___ No. Employees ___


Water Supply: ☑ Individual ☐ Public ☐ Community

☐ Slab ☐ Crawl Space ☐ Basement w/plumbing ☐ Basement wo/plumbing

Comments:/Conditions: Permit redrawn from original S&EC plan because system was installed too deep, need area between trenches to re install system and re locate repair area. Engineer

Comments:/Conditions: Drain lines checked 6/6/08
Tanks checked 6/6/08
Pressure & PM checked 7/3/08

INITIAL SITE SKETCH 191.78' 1" = 50'

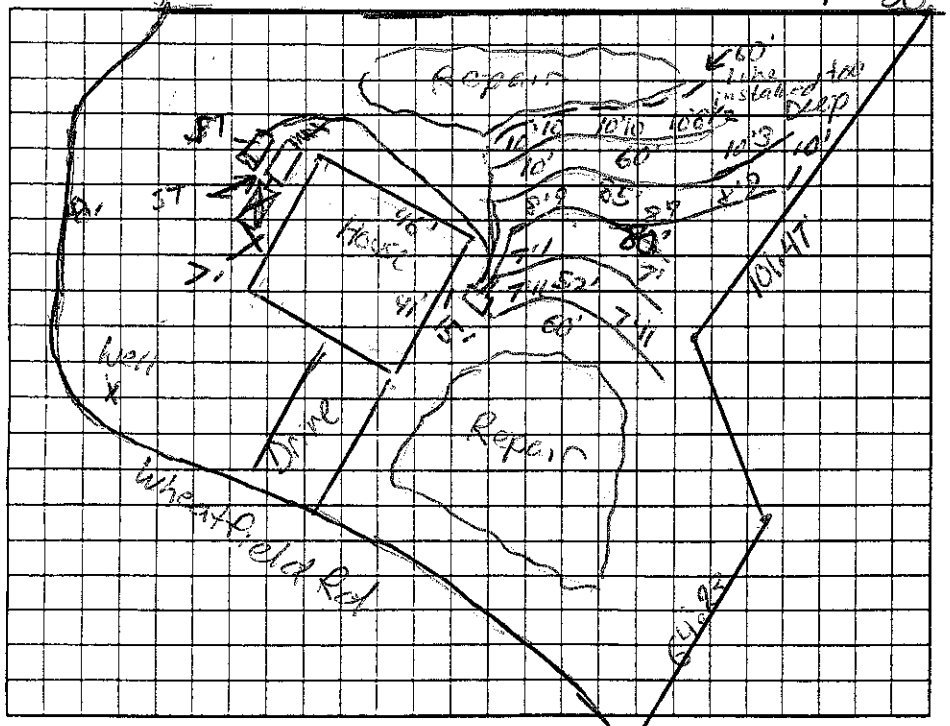

AS BUILT SKETCH

System installed as shown

Electrical checked 8/5/08

Permit can be suspended or revoked if any false information is supplied toward securing the permit/any unauthorized changes are made to the site/any unauthorized changes are made in the installation of the system. Improvement Permit with plat valid without expiration ☐ Improvement Permit with site plan valid for sixty months ☑ Authorization to Construct is valid for a period equal to that of Improvement Permit – not to exceed sixty months.

Signed: [signature] date 8-8-08 Installed by: Corinthian Builders

Improvement Permit by: Anthony Coker Jr. R.S. date 8/6/08 Operation Permit by: Anthony Coker Jr. R.S. date 8/6/08

Authorization to Construct by: Anthony Coker Jr. R.S. date 8/6/08 Existing System Inspection by: ___ date ___

HEALTH DEPT. COPY: WHITE OWNER COPY (FINAL): YELLOW OWNER COPY (INITIAL): PINK