IREDELL COUNTY HEALTH DEPARTMENT

STATESVILLE 704-878-5305 MOORESVILLE 704-664-5281

IMPROVEMENT PERMIT / AUTHORIZATION TO CONSTRUCT / OPERATION PERMIT / EXISTING SYSTEM INSPECTION

PERMIT# 111293 PIN# 4761-16-6944 DATE 3-11-03

OWNER OR CONTRACTOR FREEDOM HOMES PHONE: Business 704-528-9449 Home 704-528-9668 (FAX)

ADDRESS 1018 CHARLOTTE HWY, TROUTMAN NC 28166

LOCATION US 70 EAST, TR BETHESDA ROAD, TR FIELDCREST DRIVE, 2ND LOT ON LEFT PAST SUTTON DRIVE

SUBDIVISION WOODHAVEN BLOCK / SECTION ____ LOT 38 LOT AREA 0.88 ACRE SITE CLASS. PS DESIGN FLOW 360 L.T.A.R. 0.25 GPD/FT²

Septic Tank: 1000 Gallons; STB 794 Date 3-29-03

Pump Tank: ____ Gallons; PT ____ Date ____

Pump Make: ____ Model ____ Serial No. ____

Nitrification Field: No Fields 1 Square Feet Eq. To 1440 Linear Feet 240

No Lines EIGHT Trench Width 24" Max Trench Bottom Depth 36" ~~Gravel~~ Depth SAND 6"

☑ New System ☐ Repair System Type: I, II, III, IV, V, VI

System Description: 50% REDUCTION, GRAVITY

Repair System Description 50% REDUCTION, LOW PRESSURE

Maintenance Agreement Required: ☐ Yes ☑ No

☐ House/Mod. Home ☑ Mobile Home ☐ Business ☐ Other

No. Bedrooms 3 No. Bathrooms 2 No. Employees ____


☐ Slab ☑ Crawl Space ☐ Basement w/plumbing ☐ Basement wo/plumbing

Water Supply: ☑ Individual ☐ Public ☐ Community WELL


Comments/Conditions: ① KEEP NEW SYSTEM MINIMUM 20 FEET FROM EXISTING DRAINFIELD ② INSTALL 50% REDUCTION SYSTEM USING 56 PPBPS PANELS ③ INSTALL FLOW DIVIDER TEE TO ACHIEVE EQUAL DISTRIBUTION INTO TWO DIST. BOXES

Comments/Conditions: ① SYSTEM INSTALLED DURING PERIOD OF WET SOIL CONDITIONS ② SEPTIC TANK W/MARKER INSTALLED USING "ZABEL" FILTER.

INITIAL SITE SKETCH SCALE: 1" = 50'

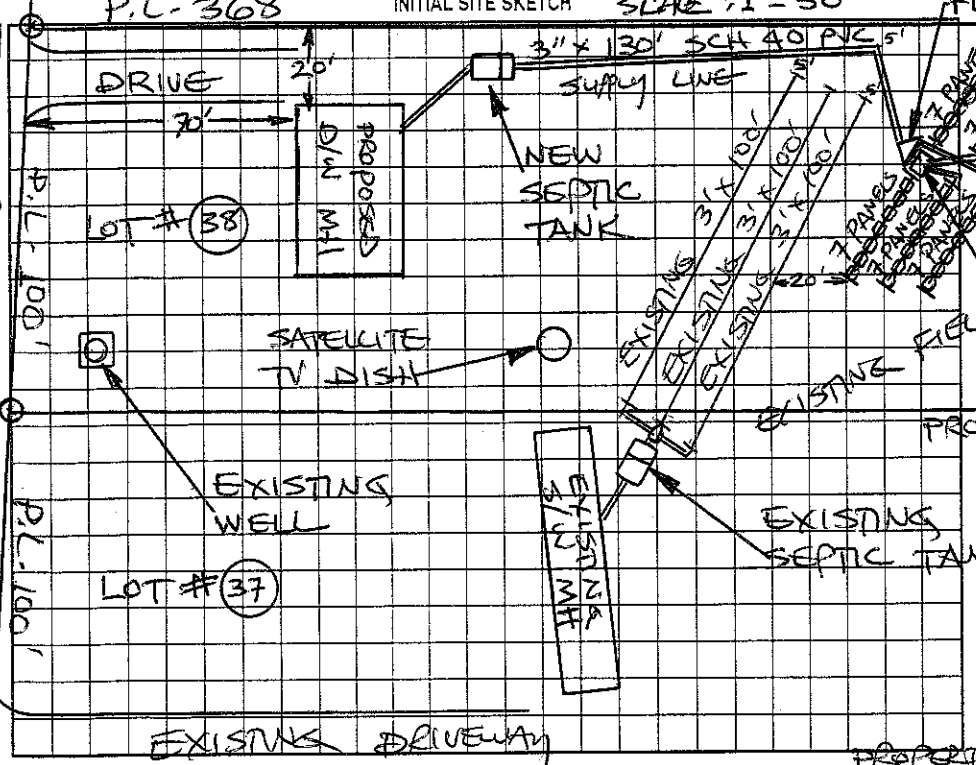

AS BUILT SKETCH

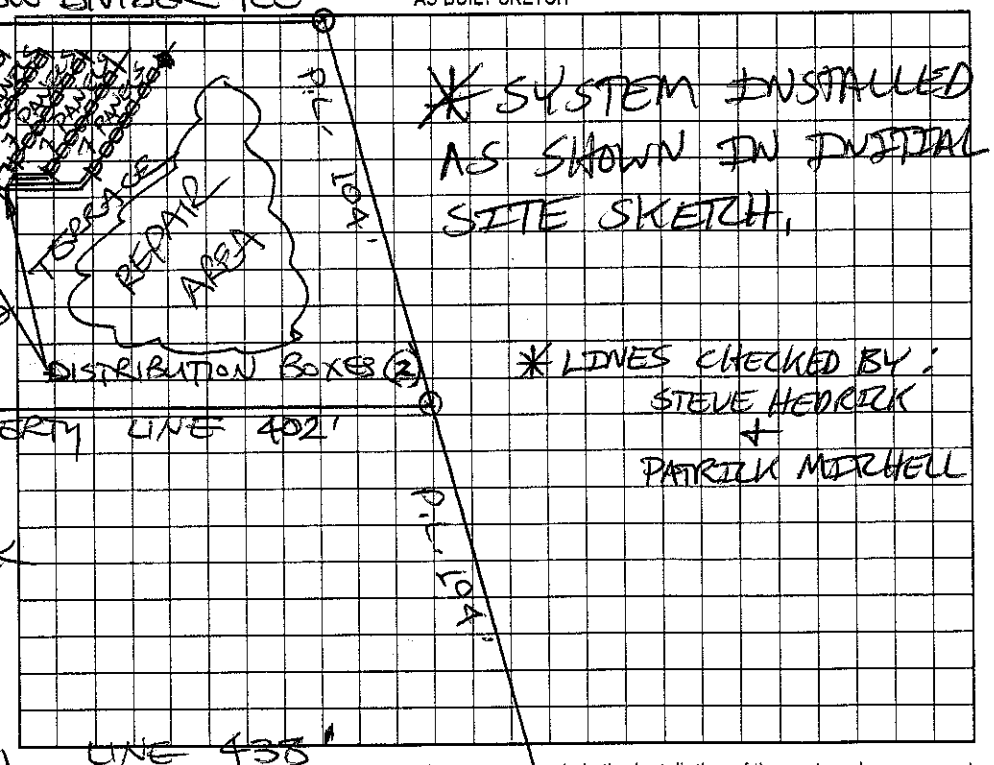

Permit can be suspended or revoked if any false information is supplied toward securing the permit/any unauthorized changes are made to the site/any unauthorized changes are made in the installation of the system. Improvement Permit with plat valid without expiration. Improvement Permit with site plan valid for sixty months. Authorization to Construct is valid for a period equal to that of Improvement Permit – not to exceed sixty months.

Signed: _____ date 3-21-03 Installed by: MARTY TUCKER

Improvement Permit by: STEVE HEDRICK date 3-11-03 Operation Permit by: Patrick Mitchell date 05/14/03

Authorization to Construct by: STEVE HEDRICK date 3-11-03 Existing System Inspection by: _____ date _____

HEALTH DEPT. COPY: WHITE OWNER COPY (FINAL): YELLOW OWNER COPY (INITIAL): PINK