IREDELL COUNTY HEALTH DEPARTMENT

STATESVILLE 704-878-5305 (CI) MOORESVILLE 704-664-5281

IMPROVEMENT PERMIT / AUTHORIZATION TO CONSTRUCT / OPERATION PERMIT / EXISTING SYSTEM INSPECTION

PERMIT# 109191 PIN# 4761-16-~~7778.B~~ 7215 DATE 10/17/02

OWNER OR CONTRACTOR DENNIS TERRY PHONE: Business _____ Home 704-636-8122

ADDRESS 13075-6 MOORESVILLE RD, MT. ULLA, NC 28125

LOCATION HWY 70 E, (R) BETHESDA RD., (R) FIELDCREST, (L) SUTTON, @ END OF CUL-DE-SAC

SUBDIVISION WOODHAVEN BLOCK / SECTION _____ LOT 51 LOT AREA 1.855 ACRES SITE CLASS. PS DESIGN FLOW 360 GPD L.T.A.R. 0.30 GPD/FT²

Septic Tank: 1,000 Gallons; STB 825 Date 8-9-03
Pump Tank: _____ Gallons; PT _____ Date _____
Pump Make: _____ Model _____ Serial No. _____
Nitrification Field: No Fields 1 Square Feet 1,200 Linear Feet 400
No Lines 5@80' Trench Width 36" Max Trench Bottom Depth 36" Gravel Depth 12"

X New System ☐ Repair System Type: I (II) III. IV. V. VI
System Description: CONVENTIONAL, GRAVITY
Repair System Description: 25% REDUCTION, GRAVITY
Maintenance Agreement Required: ☐ Yes X No


☐ House/Mod. Home No. Bedrooms 3
X Mobile Home No. Bathrooms 2
☐ Business No. Employees ____
☐ Other _____
☐ Slab X Crawl Space ☐ Basement w/plumbing ☐ Basement wo/plumbing

Water Supply: X Individual ☐ Public ☐ Community
WELL


Comments:/Conditions: (1) PLACE WELL 100' FROM SYSTEM (2) INSTALL LINES ON CONTOUR (3) MAINTAIN ALL SETBACKS

Comments:/Conditions: SEPTIC TANK WITH MARKER INSTALLED USING "POLYLOK" FILTER

INITIAL SITE SKETCH

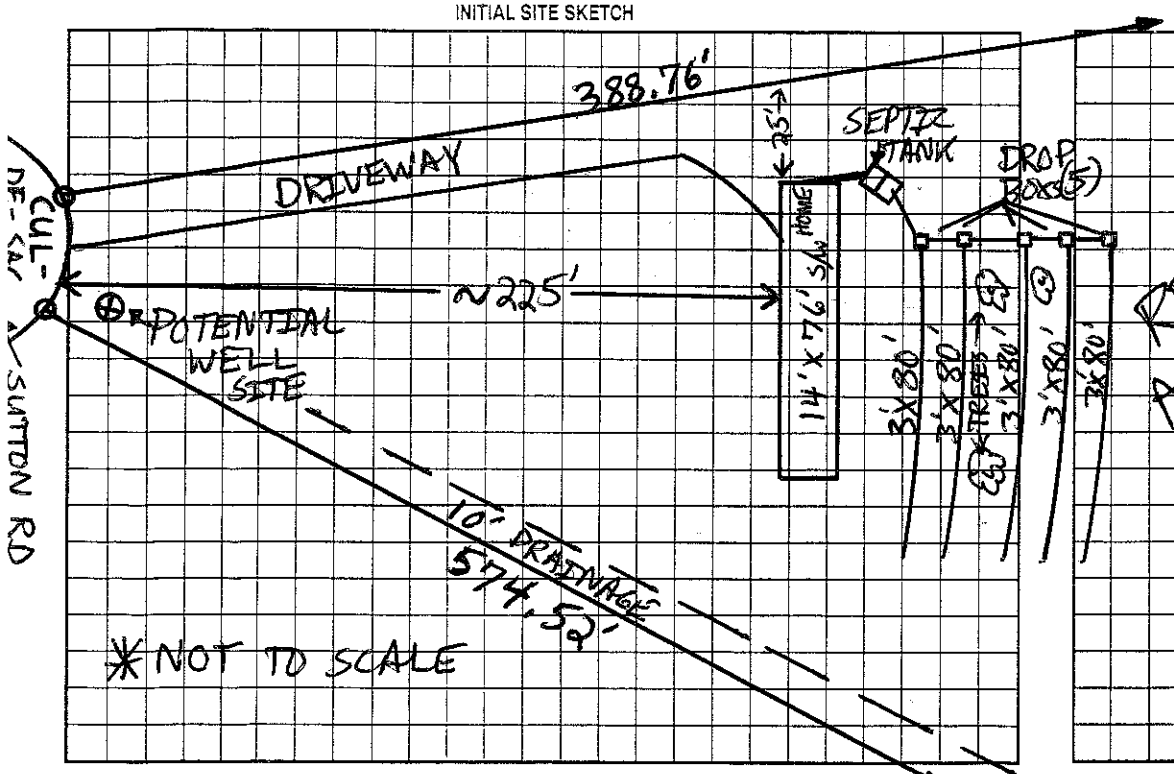

AS BUILT SKETCH

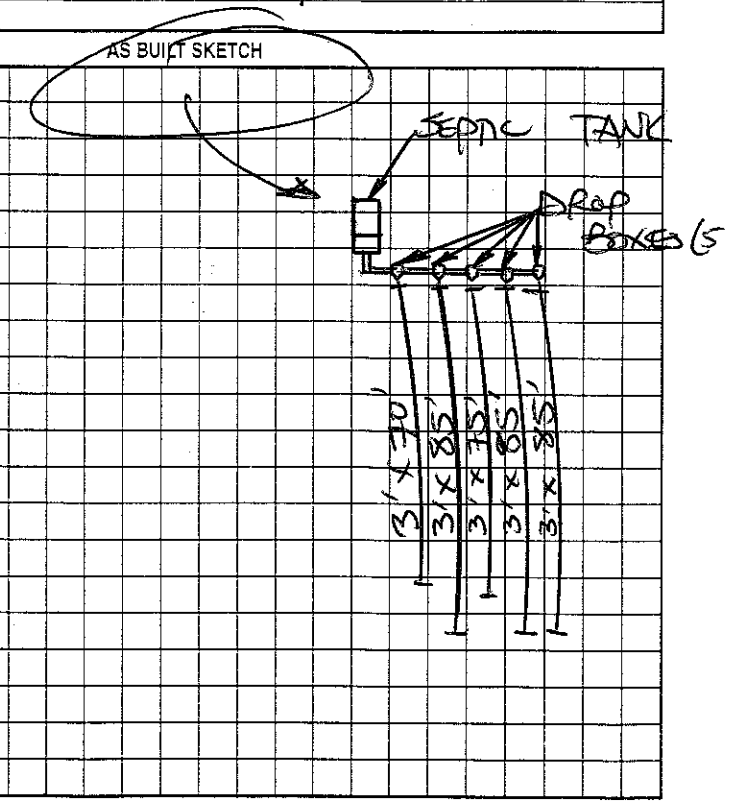

Permit can be suspended or revoked if any false information is supplied toward securing the permit/any unauthorized changes are made to the site/any unauthorized changes are made in the installation of the system. Improvement Permit with plat valid without expiration. Improvement Permit with site plan valid for sixty months. Authorization to Construct is valid for a period equal to that of Improvement Permit – not to exceed sixty months.

Signed: Dennis Terry date 10-18-02 Installed by: ROWAN SEPTIC TANK

Improvement Permit by: Patrick Mitchell date 10/17/02 Operation Permit by: STEVE HERRICK date 10-21-03

Authorization to Construct by: Patrick Mitchell date 10/17/02 Existing System Inspection by: _____ date _____

HEALTH DEPT. COPY: WHITE OWNER COPY (FINAL): YELLOW OWNER COPY (INITIAL): PINK