IREDELL COUNTY HEALTH DEPARTMENT

STATESVILLE 704-878-5305 MOORESVILLE 704-664-5281

IMPROVEMENT PERMIT / CERTIFICATE OF COMPLETION / OPERATION PERMIT / EXISTING SYSTEM INSPECTION

PROPERTY DESCRIPTION NO. 216366 DATE 9-3-97 TAX MAP NO. 4761 16 7869 Watershed: ☐ Yes ☑ No

OWNER OR CONTRACTOR Jerry Cherry PHONE: Business Home 663 3328

ADDRESS 118 Duffy Dr. Mooresville

LOCATION 70E TR Bethesda TR Fieldcrest corner Sutton Rd

SUBDIVISION Woodhaven BLOCK / SECTION LOT 39 LOT AREA SITE CLASS PS DESIGN FLOW 360 L.T.A.R. .13

Septic Tank: 1000 Gallons; STB 1012 Date 3-4-97

Pump Tank: Gallons; PT Date

Pump Make: Model Serial No

Nitrification Field: No Fields 1 Square Feet 1200 Linear Feet 400

No Lines 4 Trench Width 36" Max Trench Bottom Depth 36" Gravel Depth 12"

☑ New System ☐ Repair System Type: I, II, III, IV, V, VI

System Description: Conv. Gravity

Repair System Description: Pump to Chambers

Maintenance Agreement Required: ☐ Yes ☐ No

☐ House/Mod. Home No. Bedrooms 3

☑ Mobile Home No. Bathrooms 2

☐ Business No. Employees

☐ Other


☐ Slab ☑ Crawl Space ☐ Basement w/plumbing ☐ Basement wo/plumbing

Water Supply: ☑ Individual ☐ Community ☐ Public


Comments:

Comments:

INITIAL SITE SKETCH

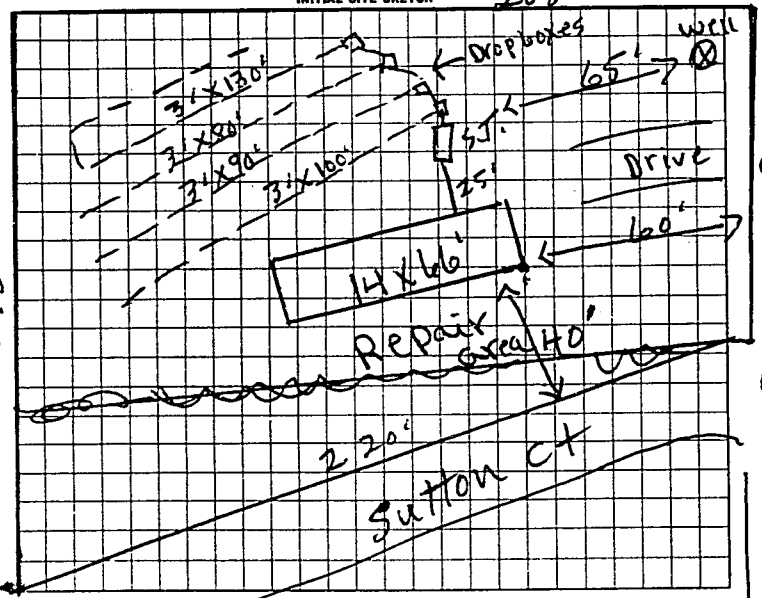

AS BUILT SKETCH

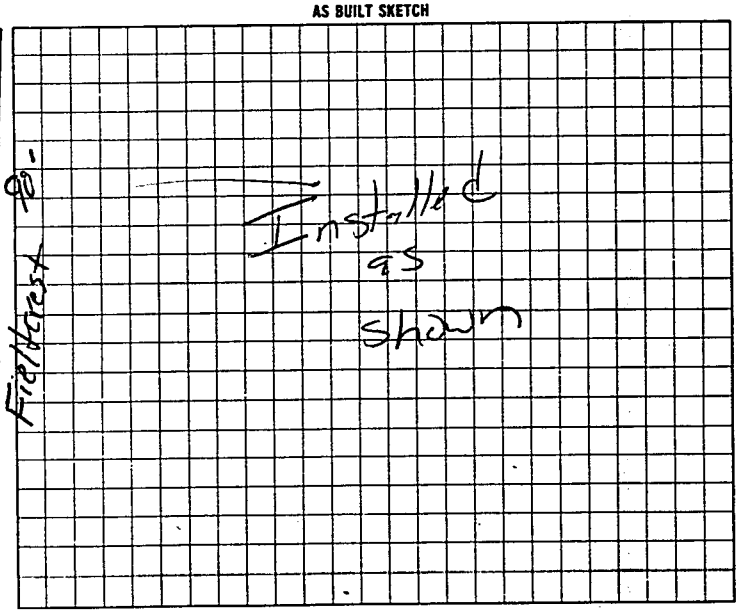

I understand that this permit can be suspended or revoked if any false information is supplied toward securing the permit/any unauthorized changes are made to the site/any unauthorized changes are made in the installation of the system.

Signed X Russell Wilson

Improvement Permit by P.C. Moore date 4-3-97

Existing System Inspection by P.C. Moore date 4-3-97

Authorization to cover

Installed by A-1 Backhoe

Certificate of Completion by date

Operation Permit by Mary C Outlaw date 5-5-97

HEALTH DEPT. COPY: WHITE INS. ECTION COPY (FINAL): GREEN OWNER COPY (FINAL): YELLOW INSPECTION COPY (INITIAL): PINK OWNER COPY (INITIAL): GOLD

Authorization to cover. Expires 60 mos from issue

0 0 0 1 2 4