IREDELL COUNTY HEALTH DEPARTMENT

STATESVILLE 704-878-5305 MOORESVILLE 704-664-5281

IMPROVEMENT PERMIT / AUTHORIZATION TO CONSTRUCT / OPERATION PERMIT / EXISTING SYSTEM INSPECTION

PERMIT# 109184 PIN# 4761-16-7778 8282 DATE 10/17/02

OWNER OR CONTRACTOR DENNIS TERRY PHONE: Business Home 704-636-8122

ADDRESS 13075-6 MOORESVILLE RD, MT. ULLA, NC 28125

LOCATION HWY 70 E., (R) BETHESDA RD., (R) FIELDCREST, (L) SUTTON, @ END OF CUL-DE-SAC

SUBDIVISION WOODHAVEN BLOCK / SECTION LOT 52 LOT AREA 1.437 ACRES SITE CLASS. PS DESIGN FLOW 360 GPD L.T.A.R. 0.30 GPD/FT²

Septic Tank: 1,000 Gallons; STB 825 Date 11/13/02
Pump Tank: Gallons; PT Date
Pump Make: Model Serial No.
Nitrification Field: No Fields 1 Square Feet 1,200 Linear Feet 400
No Lines 4 @ 100' Trench Width 36" Max Trench Bottom Depth 36" Gravel Depth 12"

[X] New System [ ] Repair System Type: I, (II), III, IV, V, VI
System Description: CONVENTIONAL GRAVITY
Repair System Description: SAME
Maintenance Agreement Required: [ ] Yes [X] No

[ ] House/Mod. Home [X] Mobile Home [ ] Business [ ] Other
No. Bedrooms 3 No. Bathrooms 2 No. Employees


[ ] Slab [X] Crawl Space [ ] Basement w/plumbing [ ] Basement wo/plumbing

Water Supply: [X] Individual [ ] Public [ ] Community: WELL


Comments/Conditions: (1) PLACE WELL 100' FROM SYSTEM (2) INSTALL LINES ON CONTOUR (3) MAINTAIN ALL SETBACKS

Comments/Conditions: SEPTIC TANK INSTALLED USING SEPTIC MARKER & POLY LOC FILTER,

INITIAL SITE SKETCH

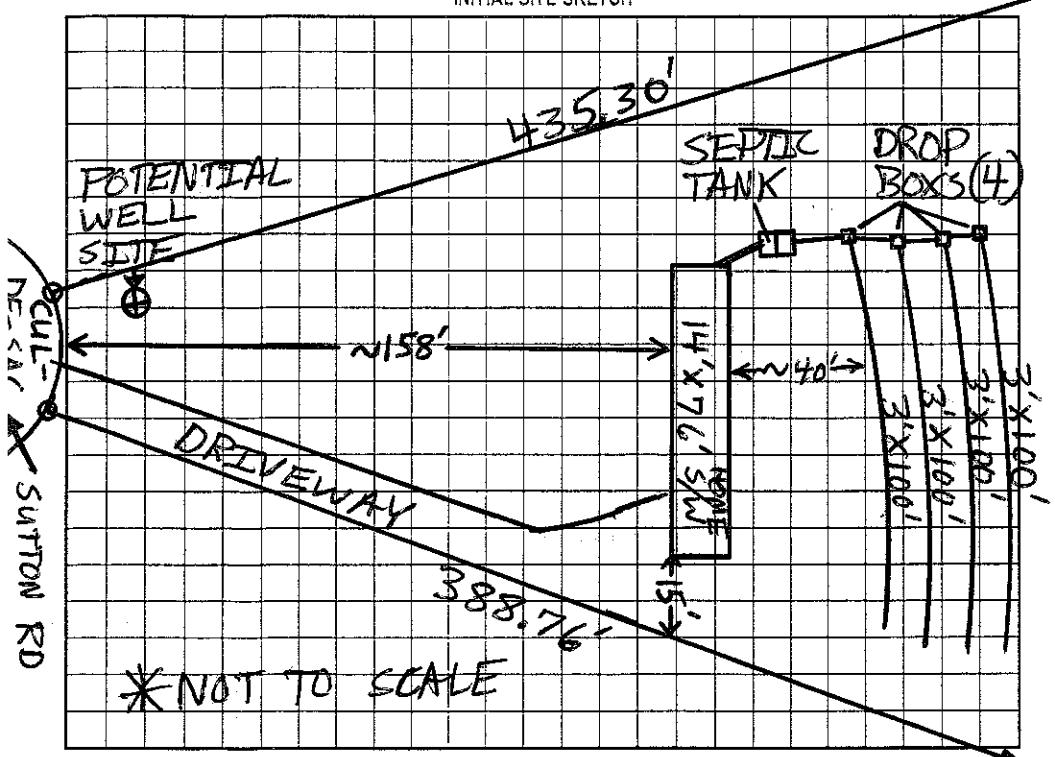

AS BUILT SKETCH

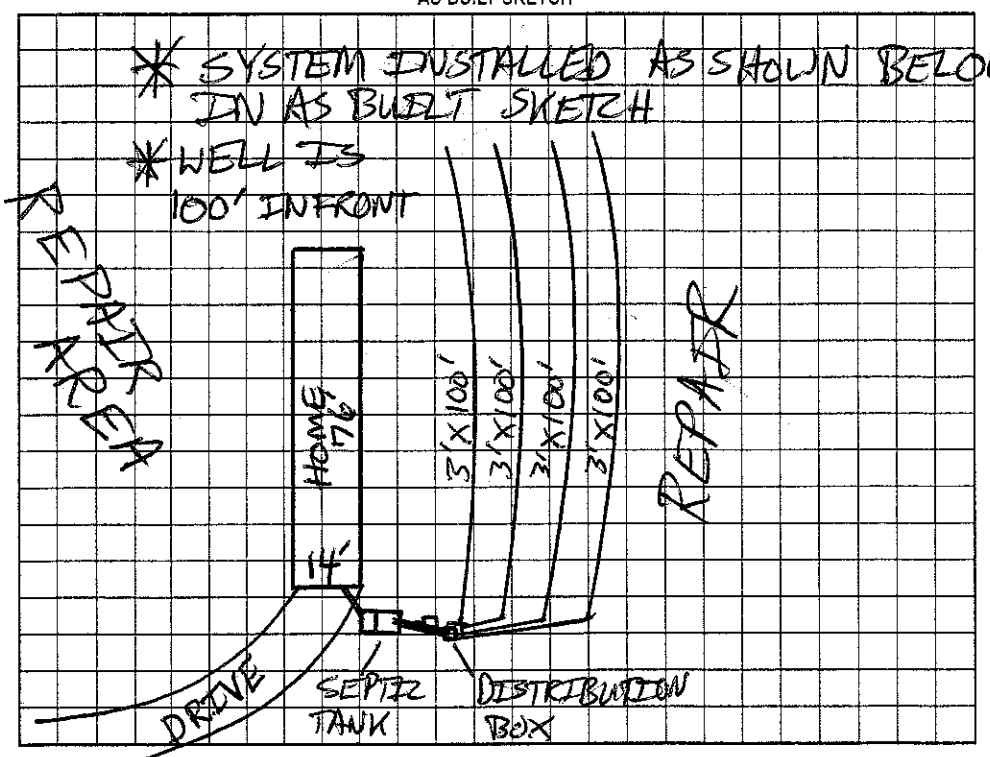

Permit can be suspended or revoked if any false information is supplied toward securing the permit/any unauthorized changes are made to the site/any unauthorized changes are made in the installation of the system. Improvement Permit with plat valid without expiration. Improvement Permit with site plan valid for sixty months. Authorization to Construct is valid for a period equal to that of Improvement Permit – not to exceed sixty months.

Signed: Dennis Terry date 10-18-02 Installed by: ROWAN SEPTIC

Improvement Permit by: Patrick Mitchell date 10/17/02 Operation Permit by: Patrick Mitchell date 01/09/03

Authorization to Construct by: Patrick Mitchell date 10/17/02 Existing System Inspection by: date

HEALTH DEPT. COPY: WHITE OWNER COPY (FINAL): YELLOW OWNER COPY (INITIAL): PINK